


DIC 2 9 1998

LAND CORNER RECORDATION CERTIFICATE
Filing Requirement of Act 74, Mich. P.A. 1970

SECTION

Form with fields for 'For corners in Mason (County)', 'Located In:', 'Corner Code #', and numbered sections 1-5 for survey details.

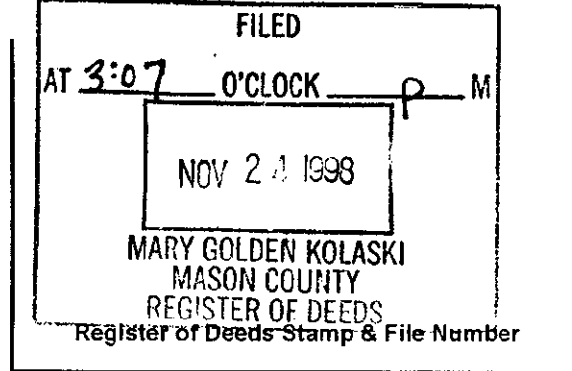

Grid table with columns A-M and rows 1-13, containing numbers 1-36.

I, Kenneth L. Ross, in a field survey on October 10, 1998, do hereby certify that under requirements of P.A. 74, Michigan P.A. of 1970, the corner points mentioned in lines 1 and 2 above were in conformance with regulations and rules therefore as required in the current manual of survey instructions of the United States Department of the Interior, Bureau of Land Management or by a decree of a Court of Law and/or that the corner points mentioned in lines 3, 4 and 5 above were in conformance with the rules of the Michigan Board of Land Surveyors or by a Decree of a Court of Law; established, re-established, monumented, re-monumented, recovered, found as expressed below:

NOTE: Not more than 4 corners, all in the same town and range, may be recorded on this certificate.

A. Description of original monument and accessories and/or subsequent restoration: J-1 N 1/4 Corner Section 2, T.19N., R.17W.,

ORIGINAL GOVERNMENT SURVEY CORNER WAS NOT SET JW Griswold, Book1, pg.252 states post established No witnesses given

MASON COUNTY ROAD COMMISSION NO DATE, FOUND 1/2" IRON (1) P.P. N32°E, 37.78' (2) T. Guy Pole, S28°E, 35.81' (3) Maple 10", S24°W, 30.53'

KENNETH L. ROSS, PLS Tied Corner on two surveys One Dated April 29, 1977 (H-246) One Dated June 17, 1996 Does not state what was found States Corner J-1 is 11.25' East of Corner J-13, T.20N., R.17W., Distance Ties, South 3295.71' to Cen Post East, 2652.24' to K-1

R.E.Lunde, RLS, 1933 Book 2, Page 316, Does not state what he found No Witnesses taken Distance East to K-1, 2668.6 Distance West to I-1, 2633.7

B. Description of corner evidence found and/or method applied in restoring or reestablishing corner: J-1 N 1/4 Corner Section 2, T.19N., R.17W.,

On October 10, 1998, I searched the area and could not locate the 1/2" iron described above. I reestablished the location of the iron using witness No. 1 above and measuring east 11.25 feet from Corner J-13, T.20N., R.17W.,

Condition of Record witnesses are as follows: (1) found in good condition, (2) found in bad condition, (3) found in bad condition.


C. Description of monument for corner and accessories established to perpetuate locating the position of the corner: J-1 N 1/4 Corner Section 2, T.19N., R.17W.,

I placed a 5/8" X 24" Re-rod by measuring from witness No. (1) S32°W, 37.78' and East 11.25 feet from Corner J-13, T.20N., R.17W., with a 3 1/2" aluminum cap stamped MASON COUNTY MONUMENT, 8" below the surface of the rod. This corner is accepted as the best available evidence of the position of the corner.

- Ext. "BT" (1) N32°E, 37.78 feet, (60d Spike NW Side) (4) Guy Pole, S 27°E, 30.96 feet, (60d Spike SW Side) (5) 24" Maple, S01° W, 32.24 feet, (60d Spike East Side) (6) 24" Maple, S 32°W, 35.96 feet, (60d Spike West Side) (7) Corner J-13, T.20N., R.17W., West 11.25 feet

Signed by [Signature] Date 11-19-98

Surveyor's Michigan License No. 17634

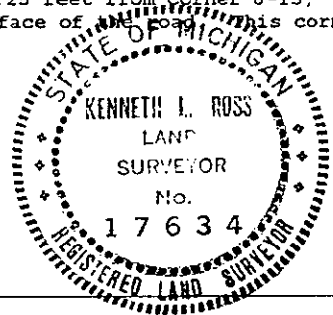

FORM APPROVED BY MICHIGAN STATE BOARD OF LAND SURVEYORS, JAN. 28, 1971 REVISED MAY 14, 1975 REVISED JAN., 1983 ADAPTED FOR WORD PROCESSING MARCH, 1993

Approved by Peer Review Group On 11-19-98 Kenneth L. Ross, County Representative [Signature]