


SURVEY &
MONUMENTATION

DEC 18 1995

COMMISSION LAND CORNER RECORDATION CERTIFICATE
Filing Requirement of Act 74, Mich. P.A. 1970

For corners in

<u>MASON</u> (County)	Located In:	Corner Code #
1. Public Land Survey	T <u>19N</u> R <u>17W</u>	<u>J-13</u>
	T _____ R _____	_____
	T _____ R _____	_____
	T _____ R _____	_____
2. Property Controlling in Section	S _____ T _____ R _____	_____
	S _____ T _____ R _____	_____
3. Miscellaneous Property in Sec.	S _____ T _____ R _____	_____
	S _____ T _____ R _____	_____

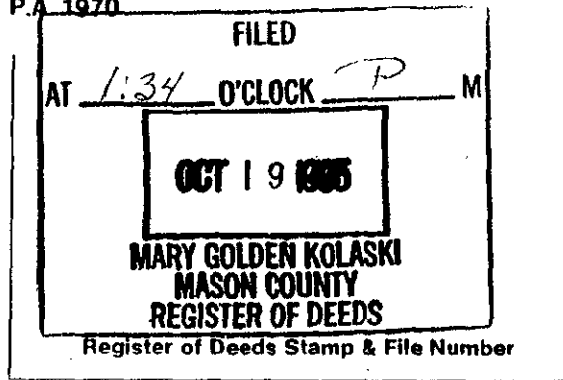

4. Lot No. _____, Recorded Plat _____
5. Private Claims _____

I, Sammy S. Barnett, in a field survey on October 10, 19 95, do hereby certify that under requirements of P.A. 74, Michigan P.A. of 1970, the corner points mentioned in lines 1 and 2 above were in conformance with regulations and rules therefore as required in the current manual of survey instructions of the United States Department of the Interior, Bureau of Land Management or by a decree of a Court of Law and/or that the corner points mentioned in lines 3, 4 and 5 above were in conformance with the rules of the Michigan Board of Land Surveyors or by a Decree of a Court of Law; established, re-established, monumented, re-monumented, recovered, found as expressed below:

A	B	C	D	E	F	G	H	I	J	K	L	M
2	6	5	4	3	2	1						
3												
4	7	8	9	10	11	12						
5												
6	18	17	16	15	14	13						
7												
8	19	20	21	22	23	24						
9												
10	30	29	28	27	26	25						
11												
12	31	32	33	34	35	36						
13												

NOTE: Not more than 4 corners, all in the same town and range, may be recorded on this certificate.

- A. Description of original monument and accessories and/or subsequent restoration:
J-13 South 1/4 Corner for Section 35, T19N, R17W, on the Township Line
- | | |
|---|---|
| <u>1838, Mullett, & Brookfield, G.L.O.</u>
Set Wood Post
#1 Pepperridge 6" N89°E 481k(31.68') | <u>1983, Ken Ross, M.C.S.</u>
Gives distance to the North 1/4
Corner, Section 2, T18N, R17W, as
12.85' |
| <u>No Date, M.C.R.C.</u>
Identifies as a Iron | |
| #2 Oak 7" NW, 47.90' | |
| #3 Oak 8" NE, 77.90' | |

- B. Description of corner evidence found and/or method applied in restoring or reestablishing corner:
J-13 South 1/4 Corner for Section 35, T19N, R17W, on the Township Line
- On October 10, 1995, I found a 1/2" Re-rod, 24" long, with RLS cap # 17634, 4 feet West of the center-line of old grade, flush with the ground, also found 1 1/2" Iron Pipe, a distance of 13.18 feet to the East, found no evidence to dispute this location for the corner.
- Condition of Recorded Witnesses is; #1 Gone #2 Gone #3 Gone

- C. Description of monument for corner and accessories established to perpetuate locating the position of the corner:
J-13 South 1/4 Corner for Section 35, T19N, R17W, on the Township Line
- I replace 1/2" cap re-rod with a 5/8" Re-rod, 24" long, with an aluminum cap(2 1/2" in dia.) stamped MASON COUNTY MONUMENT flush with the ground, and is accepted as a careful and faithful reestablishment of the position of the original corner.

- Poplar 6" S 12° W 30.46'(60d spike in SE side of tree)
- Cherry 10" N 72° E 46.38'(60d spike in NW side of tree)
- Tw. Black Oak 3" N 38° W 22.40'(60d spike in SW side of tree)
- Mason County Aluminum Cap Iron, 13.18' East, North 1/4 Corner for Section 2, T18N, R17W

Signed by Sammy S. Barnett LIBER SPACE 334 Date 10-16-95
Surveyor's Michigan License No. 16923
Peer Group Reviewed and Approved Date: 10-12-95
Kenneth L. Foss
Mason County Surveyor

