

**SURVEY & REMONUMENTATION**


DEC 18 1995

COMMISSION

**LAND CORNER RECORDATION CERTIFICATE**  
 Filing Requirement of Act 74, Mich. P.A. 1970

For corners in

MASON	Located In:	Corner Code #
(County)		
1. Public Land Survey	T 19 N. R 17 W	K-13
	T _____ R _____	_____
	T _____ R _____	_____
	T _____ R _____	_____
2. Property Controlling in Section	S _____ T _____ R _____	_____
	S _____ T _____ R _____	_____
3. Miscellaneous Property in Sec.	S _____ T _____ R _____	_____
	S _____ T _____ R _____	_____
4. Lot No. _____, Recorded Plat _____		
5. Private Claims _____		

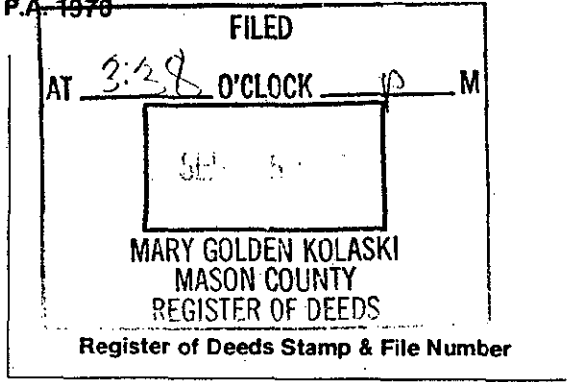

	A	B	C	D	E	F	G	H	I	J	K	L	M
2	6	5	4	3	2	1							
3													
4	7	8	9	10	11	12							
5													
6	18	17	16	15	14	13							
7													
8	19	20	21	22	23	24							
9													
10	30	29	28	27	26	25							
11													
12	31	32	33	34	35	36							
13													

I, Sammy S. Barnett, in a field survey on August 31, 1995, do hereby certify that under requirements of P.A. 74, Michigan P.A. of 1970, the corner points mentioned in lines 1 and 2 above were in conformance with regulations and rules therefore as required in the current manual of survey instructions of the United States Department of the Interior, Bureau of Land Management or by a decree of a Court of Law and/or that the corner points mentioned in lines 3, 4 and 5 above were in conformance with the rules of the Michigan Board of Land Surveyors or by a Decree of a Court of Law; established, re-established, monumented, re-monumented, recovered, found as expressed below:

**NOTE: Not more than 4 corners, all in the same town and range, may be recorded on this certificate.**

A. Description of original monument and accessories and/or subsequent restoration:

K-13 Section corner for Sections 35 and 36, T19N, R17W, on the Township Line.

1838, Mullett & Brookfield, G.L.O., Boundary  
 Set Wood Post  
 #1 Beech 7" N88°E 151ks.(9.90')  
 #2 Beech 10" N24°W 271ks.(17.82')

1981 & 1983, Ken Ross, M.C.S.  
 Found 1/2" Iron Rod  
 #3 1/2" Iron East 9.89'

Note; Undated & Unsigned Survey, in Book 1, /Page 272  
 Gives a distance of 2632.08' East to South 1/4, and  
 2640.00' North to West 1/4 Cor., Sec. 36

Distance North to East 1/4, Sec. 35 as 2629.78'  
Distance West to South 1/4, Sec. 35 as 2599.21'

1982 & 1985, Dennis Dunlap, R.L.S.  
 Found 1/2" Iron with RLS Cap

B. Description of corner evidence found and/or method applied in restoring or reestablishing corner: (OVER)

K-13 Section Corner for Sections 35 and 36, T19N, R17W, on the Township Line.

On August 31, 1995, I found a 1/2" Re-Rod at the West <sup>O</sup> shoulder of LaSalle Road (gravel), I search for other Irons or Markers or any other evidence; but found nothing to dispute this location for the Corner. I did find a 1/2" Re-Rod 9.89 feet, East in center-line of LaSalle road.

Condition of Recorded Witnesses is; #1 Gone #2 Gone #3 Found in good cond. #4 Found new Pole #5 Gone #6 Found in good cond.

C. Description of monument for corner and accessories established to perpetuate locating the position of the corner:

K-13 Section Corner for Sections 35 and 36, T19N, R17W, on the township Line.

I replaced 1/2" Re-Rod with 5/8" Re-Rod, 24" long, with an aluminum cap 2 1/2" in dia., stamped MASON COUNTY MONUMENT and placed it 0.5 feet below the shoulder of the road, and is accepted as a careful and thoughtful reestablishment of the position of the original corner.

OBT #6 NW corner of house foundation, S 42° E 144.70'  
 Power Pole N 65° E 73.67'(60d spike in NW side of Pole)  
 Red Pine 12" S 28° E 78.07'(60d spike in SW side of tree)  
 Power Pole N 19° W 41.97'(60d spike in SW side of tree)

ONE COR S 2 1/2" R 17 W EAST 9.89'

Signed by Sammy S. Barnett

Date 9-8-95

Surveyor's Michigan License 16923


Peer Group Reviewed and Approved  
 Date: 9-12-95

FORM APPROVED BY MICHIGAN STATE BOARD OF LAND SURVEYORS, JAN. 28, 1971  
 REVISED MAY 14, 1975  
 REVISED JAN., 1983

Kenneth L. Ross  
 Mason County Surveyor

Kenneth L. Ross  
 Mason County Surveyor

LIBER

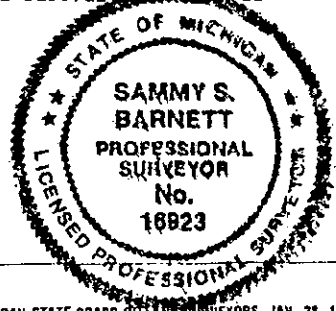

3 PAGE 294

(CONTINUE)

Section Corner for Sections 35 and 36, T19N, R17W.

1982 & 1985, Dennis Dunlap, RLS

Found 1/2 Iron with RLS Cap

#4 Power Pole N55°E 73.87'

#5 Power Pole N75°E 80.70'

#6 NW Corner of House Foundation, 144.70' S 25° E  
east, to the NE Corner of Section 2, 9.89'