


DEC 9 1998

SECTION

LAND CORNER RECORDATION CERTIFICATE
Filing Requirement of Act 74, Mich. P.A. 1970

For corners in Mason (County) Located In: Corner Code #
1. Public Land Survey T 19N. R 17W. L-1
2. Property Controlling in Section S T R
3. Miscellaneous S T R
Property in Sec. S T R
4. Lot No. Recorded Plat
5. Private Claims

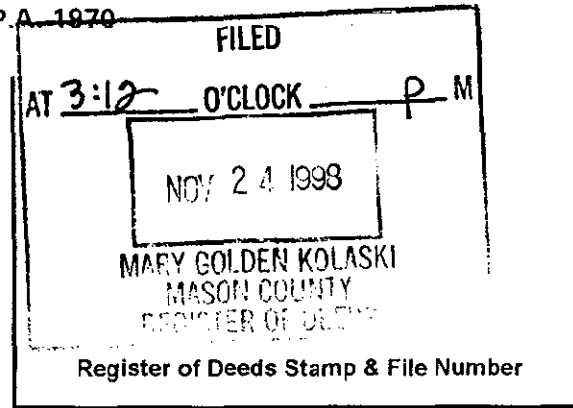

Grid table with columns A-M and rows 1-13. Cell (1, L) is shaded.

I, Kenneth L. Ross, in a field survey on October 10 1998, do hereby certify that under requirements of P.A. 74, Michigan P.A. of 1970, the corner points mentioned in lines 1 and 2 above were in conformance with regulations and rules therefore as required in the current manual of survey instructions of the United States Department of the Interior, Bureau of Land Management or by a decree of a Court of Law and/or that the corner points mentioned in lines 3, 4 and 5 above were in conformance with the rules of the Michigan Board of Land Surveyors or by a Decree of a Court of Law, established, re-established, monumented, re-monumented, recovered, found as expressed below:

NOTE: Not more than 4 corners, all in the same town and range, may be recorded on this certificate.

A. Description of original monument and accessories and/or subsequent restoration: L-1, N 1/4 Corner Section 1, T.19N., R.17W.,

ORIGINAL GOVERNMENT SURVEY R.E. Lunde, 1933
Corner was not set. Book 2, Page 316
Does not state what he found
(1) Elm, Due North, 33'
Distance East to M-1, 2635.9'
Distance West to K-1, 2633.3

Lawrence Slater, PLS, MDOT. LCRC, Liber 2, page 167
Found Plow Share, raised with 3/4" X 19" Steel Rod.
(2) N50°E, 25.48', G. Post
(3) S45°W, 21.10' G. Post
(4) N55°W, 32.26', G. Post
(5) N10°W, 54.87', Power Pole
(6) N87° 44' 40.77"W, 5.28', Stone raised with a 23"X1" steel Road


B. Description of corner evidence found and/or method applied in restoring or reestablishing corner: L-1 N 1/4 Corner Section 1, T.19N., R.17W.,

On October 10, 1998, I found a 3/4" X 19" Steel Rod as a riser to a Plow Share as described by Slater above.
Condition of Record Witnesses are as follows: (1) Gone, (2) found in good condition, (3) found in good condition, (4) found in good condition, (5) found in good condition, (6) found in good condition.

C. Description of monument for corner and accessories established to perpetuate locating the position of the corner: L-1 N 1/4 Corner Section 1, T.19N., R.17W.,

I replaced the 3/4" X 19" Steel Rod in the exact location with a 5/8" X 24" Re-rod with a 3/4" aluminum cap, stamped (MASON COUNTY MONUMENT". This corner is accepted as the best available evidence of the position of the corner.
Existing (3) Guard Rail Post, S 45°W, 21.22', (60d spike on top)
Ext. "BP" (5) P.P. N 01° W, 54.85', (60d spike East side)
(7) P.P. N 82°E, 107.17', (60d spike NW Side)
(8) Guard Rail Post, N 36°W, 22.67' (60d spike on top)
(9) Guard Rail Post, S 76°W, 53.84', (60d spike on top)
Corner L-13, West 5.20 feet.

Signed by [Signature] Date 11-19-98
Surveyor's Michigan License No. 17634

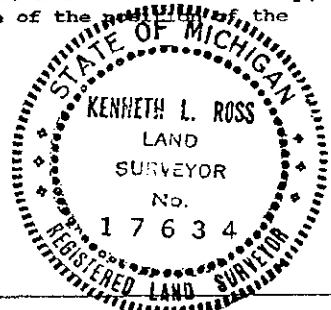

Approved by Peer Review Group On 11-19-98
Kenneth L. Ross, County Representative [Signature]

ROVED BY MICHIGAN STATE BOARD OF LAND SURVEYORS, JAN. 28, 1971
REVISED MAY 14, 1975
REVISED JAN., 1983
ADAPTED FOR WORD PROCESSING MARCH, 1993