

DEC 8 8 1993

SECTION

LAND CORNER RECORDATION CERTIFICATE

Filing Requirement of Act 74, Mich. P.A. 1970

For corners in Mason (County) Located in: Corner Code #

1. Public Land Survey T 19N R 17W L-9  
 T R  
 T R  
 T R

2. Property Controlling in Section S T R  
 S T R

3. Miscellaneous S T R

Property in Sec. S T R

4. Lot No. \_\_\_\_\_, Recorded Plat \_\_\_\_\_

5. Private Claims \_\_\_\_\_

FILED

AT 3:13 O'CLOCK P M

NOV 24 1993

MARY GOLDEN KOLASKI  
 MASON COUNTY  
 REGISTER OF DEEDS

Register of Deeds Stamp & File Number

I, Kenneth L. Ross, in a field survey on October 24, 1998, do hereby certify that under requirements of P.A. 74, Michigan P.A. of 1970, the corner points mentioned in lines 1 and 2 above were in conformance with regulations and rules therefore as required in the current manual of survey instructions of the United States Department of the Interior, Bureau of Land Management or by a decree of a Court of Law and/or that the corner points mentioned in lines 3, 4 and 5 above were in conformance with the rules of the Michigan Board of Land Surveyors or by a Decree of a Court of Law; established, re-established, monumented, re-monumented, recovered, found as expressed below:

NOTE: Not more than 4 corners, all in the same town and range, may be recorded on this certificate.

A. Description of original monument and accessories and/or subsequent restoration:

ORIGINAL GOVERNMENT SURVEY  
 Section Survey by Sylvester Silbely  
 1839 to 1839, Set Post  
 (1) Beech, 12", N32°W, 5.94'  
 (2) Beech, 8", S12°E, 20.46'

Kenneth L. Ross. Survey, 1974,  
 Unrecorded File No. H-209  
 Tied this corner no witnesses Given  
 Distance West to K-9, 2640.98'

Lawrence Slater, LCRC, 1983  
 Liber 2, page 151, Mason Co. Records  
 Found 1" Pipe in line with old trail.  
 to North and accepted and used.  
 (3) 15" Maple, N30°W, 29.55'  
 (4) 22" Cherry, N60°W, 49.72'  
 (5) 14" Ironwood, S08°E, 45.82'  
 (6) 14" Maple, S46°E, 76.43'

Kenneth L. Ross, Survey,  
 Unrecorded, 1987,  
 No Witnesses Given  
 Distance North to L-7,  
 5204.81

J. Randolph Hepworth, PLS  
 LCRC, Liber 3, Page 35, 1989  
 Found 1" Pipe  
 Witnesses (4) & (5)  
 (7) Clump 2" Maple, 352°az  
 42.44 feet  
 (8) 16" Tw Maple, 123°az  
 77.28', (RR Spike BM)

Plat of Hungry Hollow, Liber 4 of plats, pages 39A and 39B,  
 Mason County Records, Tied to this corner for line (no distance)

B. Description of corner evidence found and/or method applied in restoring or reestablishing corner:


Found 1" X 18" Pipe 0.5' below gravel surface in the centerline of road and old trail to North.

Condition of record witnesses as follows: (1) gone, (2) gone, (3) good condition, (4) good condition, (5) good condition, (6) gone, (7) gone, (8) good condition.

C. Description of monument for corner and accessories established to perpetuate locating the position of the corner:  
 Set 5/8" X 24" re-rod with a 3 1/2" aluminum cap 1.0 foot below the road surface in the exact location of the 1" X 18" Pipe. Accepted this corner as a careful and faithful re-establishment of the location of the original corner.

- Ex "BT" (3) 18" Maple, N28°W, 29.55 feet, (60d spike NE side)
- Ex "BT" (4) 24" Cherry, N60°W, 49.72 feet, (60d spike NE side)
- Ex "BT" (5) 14" Ironwood, S05°E, 45.80 feet, (60d spike West side)
- Ex "BT" (8) 18" Twin Maple, S 58°E, 77.28 feet, (RR Spike also used for MDOT BM)
- (9) 10" Maple, S65° W, 47.60 feet, (60d spike NW side)
- (10) 8" Cherry, S 11° W, 26.70 feet, (60d spike East side)

Signed by [Signature] Date 11-19-98  
 Surveyor's Michigan License No. 17634

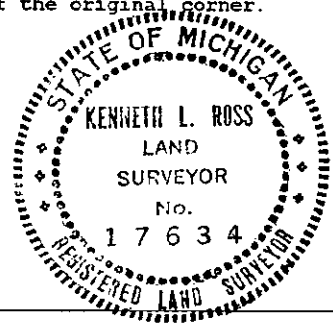

Approved by Peer Review Group On 11-19-98  
 Kenneth L. Ross, County Representative [Signature]

FORM APPROVED BY MICHIGAN STATE BOARD OF LAND SURVEYORS, JAN. 28, 1971  
 REVISED MAY 14, 1975  
 REVISED JAN., 1983  
 ADAPTED FOR WORD PROCESSING MARCH, 1993