

SURVEY & REMONUMENTATION


DEC 18 1995

COMMISSION

LAND CORNER RECORDATION CERTIFICATE
Filing Requirement of Act 74, Mich. P.A. 1970

For corners in

<u>MASON</u> (County)	Located In:	Corner Code #:
1. Public Land Survey	T 19N R 17W	H-1
	T R	
	T R	
2. Property Controlling in Section	S T R	
	S T R	
3. Miscellaneous Property in Sec.	S T R	
	S T R	
4. Lot No., Recorded Plat		
5. Private Claims		

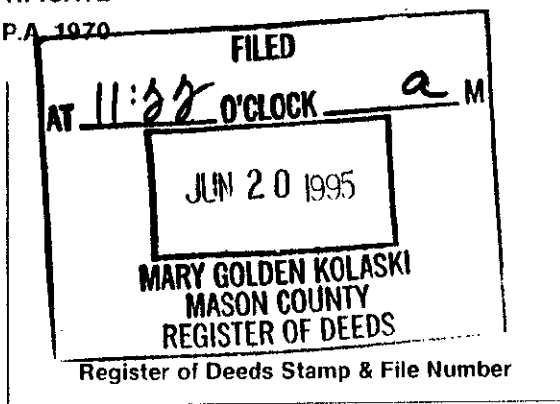

	A	B	C	D	E	F	G	H	I	J	K	L	M
2	6		5		4		3		2		1		
3													
4	7		8		9		10		11		12		
5													
6	18		17		16		15		14		13		
7													
8	19		20		21		22		23		24		
9													
10	30		29		28		27		26		25		
11													
12	31		32		33		34		35		36		
13													

I, Kenneth L. Ross in a field survey on MAY 05, 19 95 do hereby certify that under requirements of P.A. 74, Michigan P.A. of 1970, the corner points mentioned in lines 1 and 2 above were in conformance with regulations and rules therefore as required in the current manual of survey instructions of the United States Department of the Interior, Bureau of Land Management or by a decree of a Court of Law and/or that the corner points mentioned in lines 3, 4 and 5 above were in conformance with the rules of the Michigan Board of Land Surveyors or by a Decree of a Court of Law; established, re-established, monumented, re-monumented, recovered, found as expressed below:

NOTE: Not more than 4 corners, all in the same town and range, may be recorded on this certificate.

A. Description of original monument and accessories and/or subsequent restoration:

H-1 Sec. Cor., 1-19-17; 6-19-16; 36-20-17; 31-20-16
1837 Mullett & Brookfield
(1) 10" Beech N 64 W 43 lks
(2) 12" Sugar S 73 E 26 lks


B. Description of corner evidence found and/or method applied in restoring or reestablishing corner:

H-1 Sec. Cor., 1-19-17; 6-19-16; 36-20-17; 31-20-16
Feb., 1989, M.D.O.T. Fd. 1" Bar in Mon. Box US 31 & Twl. Rd. (Job No. 26668)(filed Act 74 Liber 2, Page 164)
(3) N 72 E 80.04' Power Pole
(4) S 30 E 67.50' Power Pole
(5) S 49 E 70.52' 14" Spruce
(6) S 58 E 74.14' 14" Tw. Spruce
Jul., 1963, Stephens Fd. 1" Iron in mon. box
Aug., 1965, Stephens Fd. Iron in mon. box
Jul., 1980, Slawinski Fd. Iron in mon. box (Liber 271, Page 58)
Jun., 1985, Ross used corner in survey
Aug., 1985, Ross used corner in survey

Apr., 1988, Ross Fd. Iron in mon. box
May, 1985, Ross Fd. corner destroyed by road reconstruction. Corner position restored by reconstruction of M.D.O.T. control survey using surrounding section corners.

C. Description of monument for corner and accessories established to perpetuate locating the position of the corner:

H-1 Sec. Cor., 1-19-17; 6-19-16; 36-20-17; 31-20-16
Fd witness 3 above from 1989 M.D.O.T. survey
Witness 1, 2, 4, 5, 6 above gone
Set 5/8" X 24" rebar with 2 1/2" alum. cap in mon. box, on CL US31 and on CL Townline Rd, and is accepted as the best available evidence of the original corner.
N 72 E 80.22' Power Pole
N 59 E 136.38' SW Cor. Hse.
N 21 W 135.59' Power Pole
S 15 W 217.62' Power Pole
S 47 E 132.85' NW Cor. Silage Bunker

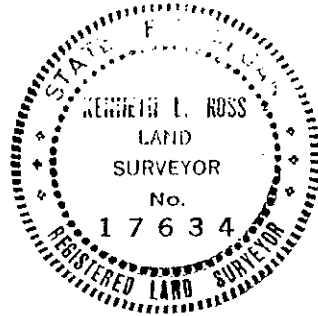

Signed by [Signature] Date 6-14-95

Surveyor's Michigan License No. 17634

Peer Group Reviewed and Approved
Date: 6-14-95
[Signature]
Kenneth L. Ross
Mason County Surveyor