

**SURVEY &
REMONUMENTATION**

DEC 18 1995

COMMISSION

LAND CORNER RECORDATION CERTIFICATE

Filing Requirement of Act 74, Mich. P.A. 1970

For corners in


MASON

(County)

Located In:

Corner Code #:

- | | | | | | |
|------------------------------------|---|-----|---|-----|-----|
| 1. Public Land Survey | T | 19N | R | 17W | M-2 |
| | T | | R | | |
| | T | | R | | |
| | T | | R | | |
| 2. Property Controlling in Section | S | T | R | | |
| | S | T | R | | |
| 3. Miscellaneous Property In Sec. | S | T | R | | |
| | S | T | R | | |

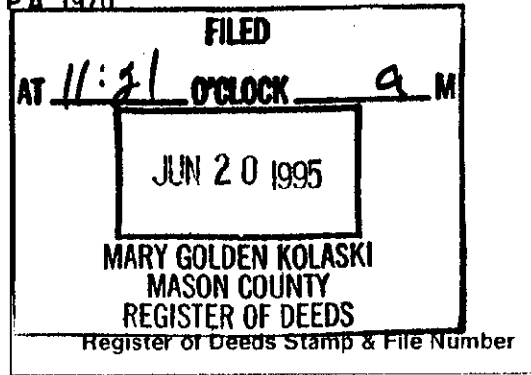

4. Lot No. _____, Recorded Plat _____
5. Private Claims _____

I, **Kenneth L. Ross**, in a field survey on **MAY 05**, 19 **95** do hereby certify that under requirements of P.A. 74, Michigan P.A. of 1970, the corner points mentioned in lines 1 and 2 above were in conformance with regulations and rules therefore as required in the current manual of survey instructions of the United States Department of the Interior, Bureau of Land Management or by a decree of a Court of Law and/or that the corner points mentioned in lines 3, 4 and 5 above were in conformance with the rules of the Michigan Board of Land Surveyors or by a Decree of a Court of Law; established, re-established, monumented, re-monumented, recovered, found as expressed below:

NOTE: Not more than 4 corners, all in the same town and range, may be recorded on this certificate.

	A	B	C	D	E	F	G	H	I	J	K	L	M
2	6	5	4	3	2	1							
3													
4	7	8	9	10	11	12							
5													
6	18	17	16	15	14	13							
7													
8	19	20	21	22	23	24							
9													
10	30	29	28	27	26	25							
11													
12	31	32	33	34	35	36							
13													

A. Description of original monument and accessories and/or subsequent restoration:


- M-2 1/4 Corner, 1-19-17 & 6-19-16
1837 Mullett & Brookfield
(1) 12" Maple N 65 W 27 lks
(2) 10" W. Pine S 43 W 37 lks

B. Description of corner evidence found and/or method applied in restoring or reestablishing corner:

- M-2 1/4 Corner, 1-19-17 & 6-19-16
Feb., 1989, M.D.O.T. Fd. 1/4" Rod in Mon. Box (Job No. 26668)(filed Act 74 Liber 2, Page 123)
(3) S 36 E 51.14' Wood Post
(4) N 16 E 66.39' SE Cor. E. Bridge Rail
(5) N 22 W 67.82' SE Cor. W. Bridge Rail
(6) S 62 W 40.08' 16" Balsam
Apr., 1962, Stephens Fd. Iron rod in mon. box, 2.1' E of HGY CL
Jul., 1980, Ross Fd. Iron in mon. box
May, 1995, Ross Fd. corner destroyed by road reconstruction. Corner position restored by reconstruction of M.D.O.T. control survey using surrounding section corners

C. Description of monument for corner and accessories established to perpetuate locating the position of the corner:

- M-2 1/4 Corner, 1-19-17 & 6-19-16
No witness from above found
Set 5/8" X 24" rebar with 2 1/2" alum. cap in mon. box, 2.0' E of CL US31, and is accepted as the best available evidence of the original corner.
S 20 W 168.90' Power Pole
S 65 E 86.27' Concrete Culvert
N 33 E 83.42' Chisel Cross Top of Conc. Headwall
N 11 W 236.20' Power Pole
N 31 W 104.27' Chisel Cross Top of Conc. Headwall
S 48 W 89.41' NE Cor. Hse.

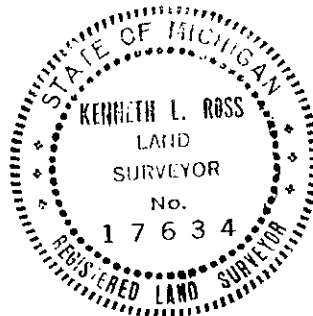

Peer Group Reviewed and Approved
Date: 6-14-95
Kenneth L. Ross
Mason County Surveyor

Signed by *[Signature]*
Surveyor's Michigan License No. 17634

Date 6-14-95