

**SURVEY &
REMONUMENTATION**

DEC 1 & 1995

COMMISSION

LAND CORNER RECORDATION CERTIFICATE
Filing Requirement of Act 74, Mich. P.A. 1970


For corners in

MASON
(County)

Located In:

Corner Code //

- | | | | | | |
|------------------------------------|---|-----|---|-----|-----|
| 1. Public Land Survey | T | 19N | R | 17W | M-3 |
| | T | | R | | |
| | T | | R | | |
| | T | | R | | |
| 2. Property Controlling in Section | S | T | R | | |
| | S | T | R | | |
| 3. Miscellaneous Property in Sec. | S | T | R | | |
| | S | T | R | | |

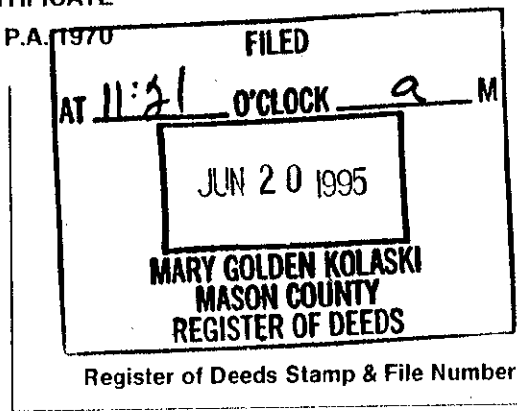

4. Lot No. _____, Recorded Plat _____
5. Private Claims _____

	A	B	C	D	E	F	G	H	I	J	K	L	M
2	6		5		4		3		2		1		
3													
4	7		8		9		10		11		12		
5													
6	18		17		16		15		14		13		
7													
8	19		20		21		22		23		24		
9													
10	30		29		28		27		26		25		
11													
12	31		32		33		34		35		36		
13													

I, Kenneth L. Ross, in a field survey on MAY 05, 1995, do hereby certify that under requirements of P.A. 74, Michigan P.A. of 1970, the corner points mentioned in lines 1 and 2 above were in conformance with regulations and rules therefore as required in the current manual of survey instructions of the United States Department of the Interior, Bureau of Land Management or by a decree of a Court of Law and/or that the corner points mentioned in lines 3, 4 and 5 above were in conformance with the rules of the Michigan Board of Land Surveyors or by a Decree of a Court of Law; established, re-established, monumented, re-monumented, recovered, found as expressed below:

NOTE: Not more than 4 corners, all in the same town and range, may be recorded on this certificate.

A. Description of original monument and accessories and/or subsequent restoration:


M-3 Sec. Cor., 1 & 12-19-17; 6 & 7-19-16
1837 Mullett & Brookfield
(1) 12" Elm N 25 W 52 lks
(2) 12" Hemlock S 42 W 57 lks

B. Description of corner evidence found and/or method applied in restoring or reestablishing corner:

M-3 Sec. Cor., 1 & 12-19-17; 6 & 7-19-16
Feb., 1989, M.D.O.T. Fd. 3/4" Pipe in Mon. Box
(Job No. 26668)(filed Act 74 Liber 2, Page 154)
(3) N 75 W 139.56' Power Pole
(4) N 53 W 39.04' Power Pole
(5) S 49 E 48.76' Wood Post
(6) N 85 E 172.31' Power Pole
May, 1995, Ross Fd. existing 3/4" pipe in remains of mon. box.

C. Description of monument for corner and accessories established to perpetuate locating the position of the corner:

M-3 Sec. Cor., 1 & 12-19-17; 6 & 7-19-16
Fd witness 6 above from 1989 M.D.O.T. survey
Witness 1, 2, 3, 4, 5 above gone
Set 5/8" X 24" rebar inside existing 3/4" pipe with 2 1/2" alum. cap in mon. box, 2.0' E of CL US31, and is accepted as the best available evidence of the original corner.
N 84 E 172.20' Power Pole
N 18 W 148.63' Power Pole
N 78 W 137.58' Power Pole
S 16 W 201.27' Power Pole
S 56 E 85.13' Sign Post

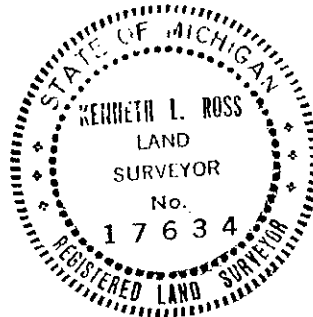

Signed by _____

Date 6-14-95


Peer Group Reviewed and Approved
Date: 6-14-95
Kenneth L. Ross
Mason County Surveyor