

**SURVEY & REMONUMENTATION**

DEC 18 1995

**COMMISSION**

**LAND CORNER RECORDATION CERTIFICATE**

Filing Requirement of Act 74, Mich. P.A. 1970


For corners in

MASON  
(County)

Located In:

Corner Code #

- 1. Public Land Survey T 19N R 17W H-5  
T R  
T R  
T R
- 2. Property Controlling in Section S T R  
S T R
- 3. Miscellaneous Property in Sec. S T R  
S T R
- 4. Lot No. , Recorded Plat
- 5. Private Claims

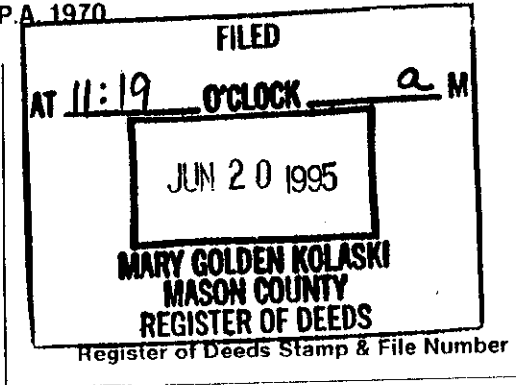

	A	B	C	D	E	F	G	H	I	J	K	L
2	6		5		4		3		2		1	
3												
4	7		8		9		10		11		12	
5												
6	18		17		16		15		14		13	
7												
8	19		20		21		22		23		24	
9												
10	30		29		28		27		26		25	
11												
12	31		32		33		34		35		36	
13												

I, Kenneth L. Ross, in a field survey on MAY 05, 1995, do hereby certify that under requirements of P.A. 74, Michigan P.A. of 1970, the corner points mentioned in lines 1 and 2 above were in conformance with regulations and rules therefore as required in the current manual of survey instructions of the United States Department of the Interior, Bureau of Land Management or by a decree of a Court of Law and/or that the corner points mentioned in lines 3, 4 and 5 above were in conformance with the rules of the Michigan Board of Land Surveyors or by a Decree of a Court of Law; established, re-established, monumented, re-monumented, recovered, found as expressed below:

**NOTE: Not more than 4 corners, all in the same town and range, may be recorded on this certificate.**

A. Description of original monument and accessories and/or subsequent restoration:

- H-5 Section Cor., Secs. 12 & 13-19-17; 7 & 18-19-16  
1837 Mullett & Brookfield  
(1) 12" Tree ? S 41 W 12 lks  
(2) 10" Hemlock N 51 W 30 lks

B. Description of corner evidence found and/or method applied in restoring or reestablishing corner:


- H-5 Section Cor., Secs. 12 & 13-19-17; 7 & 18-19-16  
Feb., 1989, M.D.O.T. Fd. 1" Bar in Mon. Box (Job No. 26668)(filed Act 74 Liber 2, Page 124)  
(3) S 44 W 75.68' NE Cor of Metal Bldg  
(4) N 66 E 74.54' Telephone Pole  
(5) S 62 E 77.98' Telephone Pole  
(6) S 65 W 89.39' 18" Balsam  
Jun., 1960, Stephens Fd. Pipe in mon. box  
Jan., 1974, Ross used corner in survey  
May, 1977, Richards Fd. 1" Iron in mon. box (Liber 1 R.C.S., Page 454)  
Feb., 1980, Hays Fd. Iron in mon. box (Liber 264, Page 272)

Mar., 1994, Ross used corner in survey  
May, 1995, Ross Fd. existing 1" bar in remains of mon. box.

C. Description of monument for corner and accessories established to perpetuate locating the position of the corner:

- H-5 Section Cor., Secs. 12 & 13-19-17; 7 & 18-19-16  
Fd witness 3 above from 1989 M.D.O.T. survey  
Witness 1, 2, 4, 5, 6 above gone  
Set 5/8" X 24" rebar with 2 1/2" alum. cap at angle to center cap over existing 1" bar and replaced mon. box, 1.2' E of CL US31 and on CL Fountain Rd, and is accepted as the best available evidence of the original corner.  
N 46 W 110.00' Power Pole  
S 67 W 90.42' 18" Balsam  
S 46 W 75.70' NE Cor. Bldg.  
S 49 E 90.62' Power Pole

N 38 E 88.33' Concrete Culvert

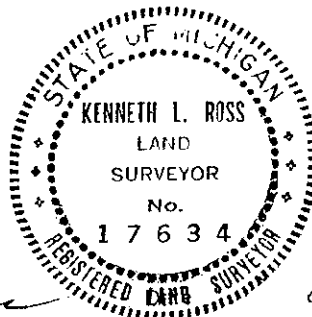

Peer Group Reviewed and Approved  
Date: 6-14-95  
Kenneth L. Ross  
Mason County Surveyor

Signed by Kenneth L. Ross  
Surveyor's Michigan License No. 17634

FORM APPROVED BY MICHIGAN STATE BOARD OF LAND SURVEYORS, JAN. 21  
REVISED MAY 1  
REVISED JAN