

**SURVEY & REMONUMENTATION
LAND CORNER RECORDATION CERTIFICATE**

APR 28 1995 FILING REQUIREMENT OF ACT 74, MICH. P.A.1970

COMMISSION
FOR CORNERS OF--

LOCATED IN--

1. PUBLIC LAND SURVEY _____ T. 20N N. S., R. 15W E. W.

2. PROPERTY CONTROLLING IN SECTION _____ T. _____ N. S., R. _____ E. W.

3. MISCELLANEOUS PROPERTY IN SECTION _____ T. _____ N. S., R. _____ E. W.

4. LOT NO. _____, RECORDED PLAT _____

5. PRIVATE CLAIMS _____

FILED

10:10 O'CLOCK a M

NOV 17 1994


**MARY GOLDEN KOLASKI
MASON COUNTY
REGISTER OF DEEDS**

REGISTER OF DEEDS STAMP AND FILING NUMBER

I, Patrick R. Leemon do hereby certify that under requirements of P.A. 74, Michigan P.A. of 1970, the corner points mentioned in lines 1 and 2 above (identified with circles on index code diagram - over) were, in a field survey on October 30 1994, established, re-established, monumented, re-monumented, recovered or restored as expressed below and in conformance with regulations and rules therefore as required in the current manual of survey instructions of the United States Department of the Interior, Bureau of Land Management or by a decree of a court of law. Furthermore, that the corner points mentioned in lines 3, 4 and 5 above were, in a field survey on _____ 19____, found, recovered, restored, established or re-established as expressed below and in conformance with the rules of the Michigan State Board of Registration for Land Surveyors or, by a Decree of a Court of law:

- A. Description of original monument and accessories and/or subsequent restoration:
Closing North Quarter Corner of section 6 of T20N R15W
 This corner was not est. by GLO
- | | |
|--|--|
| <p>1918 survey by C.E. Mitchell
 No monument mentioned
 #1 Oak 9 N49W 77 links
 #2 Oak 13 N70E 93 links</p> | <p>1972 survey by Robert A. Griffin #13584
 Fd. wit. #2 from County Surveyor C.E. Mitchell. Set a 5" sq. by 36" long conc. monu. w/ brass cap.
 #3 W.Oak 7 S36E 83.15 feet
 #4 W.Oak 5 S7E 69.88 feet
 #5 P.Post 4 South 33.10 feet
 #6 B.Oak 8 S41W 89.96 feet
 #7 S1/4 32 T21N R15W west 244.00 ft.</p> |
|--|--|
- B. Description of corner evidence found and/or method applied in restoring or re-establishing corner:
 I found the 5" square by 36" long concrete monument w/ brass cap by Griffin buried 3" beneath the surface and 10 feet North of the centerline of the E-W road. Witnesses 1, 2 and 5 are gone. Witness 3, 4, 6 and 7 are in good condition. Liber 1 Page 79 by Griffin documents the history of this corner. I could find no conflicting information that would lead to another location. I therefore accept the found monument as the best available evidence of the position of the corner. The corner is of the centerline of FR 8365 to the south.

- C. Description of monument for corner and accessories established to perpetuate locating the position of the corner:
Closing North Quarter Corner of section 6 of T20N R15W
 Monu. The 5" square by 36" long concrete monu. with 3" brass disk was left in place.
 Witnesses:
 Rebar 5/8" x 24" N42W 61.66 feet
 Rebar 5/8" x 24" N51E 69.15 feet
 W.Oak 10 S36E 83.15 feet (#3)
 W.Oak 9 S7E 69.81 feet (#4)
 B.Oak 12 S41W 89.96 feet (#6)

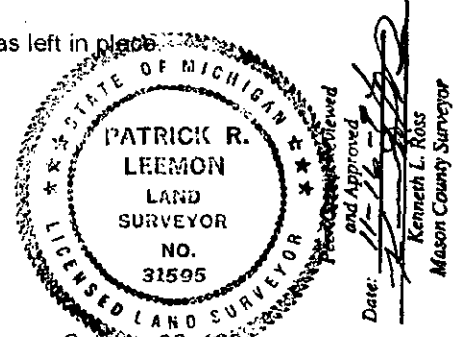

SIGNED BY Patrick R. Leemon DATE October 30, 1994

SURVEYOR'S MICHIGAN REGISTRATION NO. 31595 (SEAL)

FOR STATE AND UNITED STATES AGENCIES:

SIGNED BY _____ DATE _____
CHIEF OF SURVEY PARTY

APPROVED AND SIGNED BY _____ DATE _____
MICHIGAN REGISTERED LAND SURVEYOR (SEAL)

LIBER 3 PAGE 198