

**SURVEY &
REMONUMENTATION**

APR 28 1995 LAND CORNER RECORDATION CERTIFICATE

COMMISSION FILING REQUIREMENT OF ACT 74, MICH. P.A.1970

FOR CORNERS OF -- LOCATED IN -- CORNER CODE NUMBER

1. PUBLIC LAND SURVEY T. 20N N. 15W E. S., R. W. C1

2. PROPERTY CONTROLLING IN SECTION , T. N. S., R. E. W. *log 1*

3. MISCELLANEOUS PROPERTY IN SECTION , T. N. S., R. E. W.

4. LOT NO. _____, RECORDED PLAT _____

5. PRIVATE CLAIMS _____

FILED

AT 10:10 O'CLOCK a M

NOV 17 1994

MARY GOLDEN KOLASKI
MASON COUNTY
REGISTER OF DEEDS

REGISTER OF DEEDS STAMP AND FILING NUMBER

I, Patrick R. Leemon do hereby certify that under requirements of P.A. 74, Michigan P.A. of 1970, the corner points mentioned in lines 1 and 2 above (identified with circles on index code diagram - over) were, in a field survey on October 30 1994, established, re-established, monumented, re-monumented, recovered or restored as expressed below and in conformance with regulations and rules therefore as required in the current manual of survey instructions of the United States Department of the Interior, Bureau of Land Management or by a decree of a court of law. Furthermore, that the corner points mentioned in lines 3, 4 and 5 above were, in a field survey on _____ 19____, found, recovered, restored, established or re-established as expressed below and in conformance with the rules of the Michigan State Board of Registration for Land Surveyors or, by a Decree of a Court of law:

- A. Description of original monument and accessories and/or subsequent restoration:
- Section corner common to sections 5 and 6 of T20N R15W**
- | | | |
|---|---|--|
| 1838 survey by Mullett & Brookfield Set Wood Post #1 P. Pine 4 S22E 15 links #2 W. Oak 4 S14W 40 links #3 SW 33 T21N R15W West 350 lks. | 1918 survey by C.E. Mitchell Fd. stake & wit. #5 #6 Oak 6 S45E 68 links #5 Oak 6 S55W 45 links | 1972 survey by Robert A. Griffin Found wit. #6 & set a 5" sq. by 36" long conc. monu. w/ a 3" brass disk. #7 NW cor. of cabin S15E 217.37 feet #8 W. Oak 6 S52W 122.27 feet #9 P. Post South 33.02 feet #10 W. Oak 6 S25W 41.90 feet #6 B. Oak 16 S45E 45.12 feet #3 SW 33 T21N R15W West 231.00' |
|---|---|--|
- 1910 survey by Robert G. Townn
Set Cor. from wit's. #2 & 3
#4 B. Oak 8 S24 1/2 E 42 links
#5 W. Oak 10 S51 1/2 W 44 links

B. Description of corner evidence found and/or method applied in restoring or re-establishing corner:
I found the 5" square by 36" long concrete monument w/ brass cap by Griffin buried 4" beneath the surface and 7 feet North of the centerline of the E-W road. Witnesses 1, 2, 4 and 5 are gone. Witness 3 and 6 through 10 are in good condition. Liber 1 Page 152 by Griffin documents the history of this corner. This corner was used in a 1980 survey by Tony Slawinski #13597 and by Ken Ross #17634 in 1975. This monument is accepted as a careful and faithful perpetuation of the position of the original corner.

C. Description of monument for corner and accessories established to perpetuate locating the position of the corner:
Section corner common to sections 5 and 6 of T20N R15W
Monu. The 5" square by 36" long concrete monu. with 3" brass disk was left in place.
Witnesses:
W. Oak 10 N9W 35.02 feet
W. Oak 11 N35E 59.59 feet
P. Post 4 South 33.96 feet (#9)
W. Oak 10 S15W 41.93 feet (#10)
B. Oak 19 S45E 45.15 feet (#6)

Peer Group Reviewed and Approved
Date: _____
Kenneth L. Ross
Mason County Surveyor


SIGNED BY Patrick R. Leemon DATE October 30, 1994
31595

SURVEYOR'S MICHIGAN REGISTRATION NO. _____

FOR STATE AND UNITED STATES AGENCIES:

SIGNED BY _____ DATE _____
CHIEF OF SURVEY PARTY

APPROVED AND SIGNED BY _____
MICHIGAN REGISTERED LAND SURVEYOR

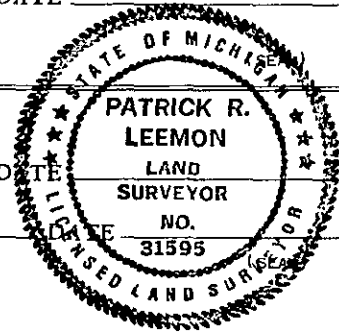

LIBER 3 PAGE 199