

SURVEY & REMONUMENTATION

APR 28 1995 LAND CORNER RECORDATION CERTIFICATE
COMMISSION FILING REQUIREMENT OF ACT 74, MICH. P.A.1970

FOR CORNERS OF--:	LOCATED IN--:	CORNER CODE NUMBER
1. PUBLIC LAND SURVEY _____	T. 20N N. 15W E. S., R. W.	E1
2. PROPERTY CONTROLLING IN SECTION _____	, T. N. S., R. E. W.	<i>Seg. 1</i>
3. MISCELLANEOUS PROPERTY IN SECTION _____	, T. N. S., R. E. W.	
4. LOT NO. _____, RECORDED PLAT _____		
5. PRIVATE CLAIMS _____		

FILED

AT 10:10 O'CLOCK a M

NOV 17 1994

MARY GOLDEN KOLASKI
MASON COUNTY
REGISTER OF DEEDS

REGISTER OF DEEDS STAMP AND FILING NUMBER

I, Patrick R. Leemon do hereby certify that under requirements of P.A. 74, Michigan P.A. of 1970, the corner points mentioned in lines 1 and 2 above (identified with circles on index code diagram - over) were, in a field survey on October 30 1994, established, re-established, monumented, re-monumented, recovered or restored as expressed below and in conformance with regulations and rules therefore as required in the current manual of survey instructions of the United States Department of the Interior, Bureau of Land Management or by a decree of a court of law. Furthermore, that the corner points mentioned in lines 3, 4 and 5 above were, in a field survey on _____ 19____, found, recovered, restored, established or re-established as expressed below and in conformance with the rules of the Michigan State Board of Registration for Land Surveyors or, by a Decree of a Court of law:


- A. Description of original monument and accessories and/or subsequent restoration:
- | | | |
|---|--|--|
| Section corner common to sections 4 and 5 of T20N R15W | | |
| 1838 survey by Mullett & Brookfield
Set Wood Post
#1 W.Oak S25W 30 links
#2 W.Oak 10 S45E 26 links | 1936 search by Carl Kintz USFS
Fd. conc. monu. by Mitchell
No witnesses were taken | 1971 survey by Robert A. Griffin 13584
Found the conc. monu. by Mitchell and set a 5" sq. by 60" long conc. monu. w/ a 3" brass disk. |
| 1918 survey by C.E. Mitchell
Set Conc. Monu. w/ 1" gas pipe
#3 Pine 16 S18 1/2 W 54 links
#4 Pine 14 S57E 38 links | 1985 survey by A.Slawinski #13597
Fd. Griffin monu.
#5 Oak 14 N70E 12.78 feet
#6 Pine 8 S10E 35.64 feet
#7 Maple 7 S65W 51.42 feet
#8 Pine 22 S10W 52.95 feet | #8 R.Pine 17 S10W 52.95 feet
#9 W.Pine 3 S71W 62.83 feet |

B. Description of corner evidence found and/or method applied in restoring or re-establishing corner:

I found the 5" square by 60" long concrete monument w/ brass cap by Griffin extending 18" above the surface and 650 feet North of the centerline of the E-W road. Witnesses 1 through 4 are gone. Witness 5 through 9 are in good condition. I could not find a recorded corner certificate by Griffin even though I'm certain one was filed. This monument has been used by Richard Hays #25847 and Clint Cole #17615. I could find no conflicting information that would lead to another location. I therefore accept this monument as a careful and faithful reestablishment of the position of the original corner.

C. Description of monument for corner and accessories established to perpetuate locating the position of the corner:

Section corner common to sections 4 and 5 of T20N R15W
 Monu. The 5" square by 60" long concrete monu. with 3" brass disk was left in place.
 Witnesses:
 Rebar 5/8" x 24" N22W 95.32 feet
 SW 34 T21N R15W 5x60 conc. monu. West 115.90 feet
 B.Oak 14 N76E 12.78 feet (#5)
 R.Pine 9 S10E 35.64 feet (#6)
 R.Maple 7 S65W 51.39 feet (#7)
 R.Pine 19 S10W 52.71 feet (#8)

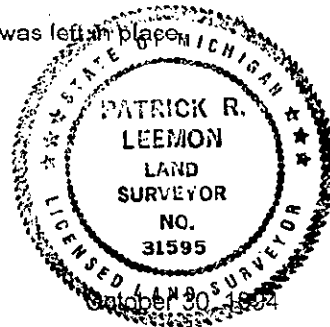

Peer Group Reviewed and Approved
 Date: 11-16-94
 Kenneth L. Ross
 Mason County Surveyor

SIGNED BY Patrick R. Leemon DATE _____
 SURVEYOR'S MICHIGAN REGISTRATION NO. 31595 (SEAL)

FOR STATE AND UNITED STATES AGENCIES:
 SIGNED BY _____ DATE _____
 CHIEF OF SURVEY PARTY
 APPROVED AND SIGNED BY _____ DATE _____
 MICHIGAN REGISTERED LAND SURVEYOR (SEAL)