

MAR 08 1994

COMMISSION


LAND CORNER RECORDATION CERTIFICATE
Filing Requirement of Act 74, Mich. P.A. 1970

For corners in

MASON County

Located in:

Corner Code 11

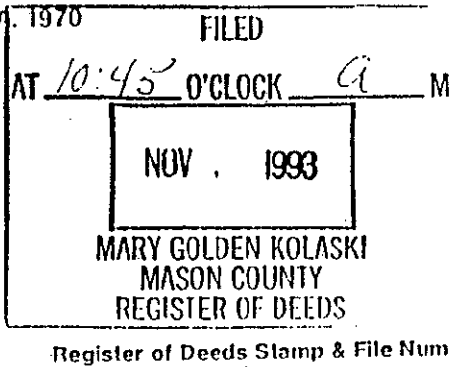

- 1 Public Land Survey T 20N R 15W
T 20N R 15W
T R
T R
2 Property Controlling S T R
in Section S T R
3 Miscellaneous S T R
Property in Sec. S T R



4 Lot No. Recorded Plat
5 Private Claims

Grid table with columns A-L and rows 2-13.

I, John Schulke, in a field survey on Oct. 4th & 20th 1993 do hereby certify that under requirements of P.A. 74, Michigan P.A. of 1970, the corner points mentioned in lines 1 and 2 above were in conformance with regulations and rules therefor as required in the current manual of survey instructions of the United States Department of the Interior, Bureau of Land Management or by a decree of a Court of Law and/or that the corner points mentioned in lines 3, 4 and 5 above were in conformance with the rules of the Michigan Board of Land Surveyors or by a Decree of a Court of Law; established, re-established, monumented, re-monumented, recovered, found as expressed below:

NOTE: Not more than 4 corners, all in the same town and range, may be recorded on this certificate.

A Description of original monument and accessories and/or subsequent restoration:

E-13 Original survey established in 1838 by J. Mullett. Set a wooden post with the following references: Bearing trees: W. pine 18" N45°W 33 lks. Maple 7" N59°E 30 lks. In 1838, Sibley set a wood post for the Closing Corner for Sections 4 and 5 26 lks. East of Standard Corner of Sections 32 and 33. In 1890, the Manistee/Grand Rapids Railroad recovered corner and measured East 1990 ft. to center line of Grade. No references. CONTINUE ON BACK

F-13 Original survey established in 1838 by J. Mullett. Set a wooden post with the following references: Bearing trees: W. Pine 12" N15°E 6 lks. Maple 6" N21°W 25 lks. In 1890, Manistee/Grand Rapids Railroad recovered corner 650.5 feet East of Station 690144.5. In 1979, K. Ross set 1/2" rebar by proportionate measurement between F-13 and I-13.


CONTINUE ON BACK

B Description of corner evidence found and/or method applied in restoring or reestablishing corner:

E-13 Found Griffin monument and the 3/4" iron rod East 17.16 ft as described on certificate. From iron rod measured N45°W a distance of 21.8 ft. and found 20" pine stump. Found stump hole bearing N59°E a distance of 19.8 feet. Going East 18 ft. found evidence of Closing Corner to Sections 4 and 5 (see E-1, T19N, R15W). Found remains of decayed wood post on South side of iron tapering to a point 24" below ground level. Found rusted location tag marking the corner as Sections 4 and 5.

F-13 Found monument as described by R. Griffin. By going S89°54'20"E from the new position of the Standard corner of Sections 32 and 33 measured 2642.14 feet. Found decayed 18" pine stump N15°E a distance of 4 feet, a stump hole N21°W a distance 16.5 ft and the line intersects an abandoned railroad grade 650 ft. West to verify position.

NOTE: Careful examination of the evidence found Dysterhouse blunder in calling recovered post, corner of Sections 4 and 5 rather than the correct call of the Standard corner to Sections 32 and 33.

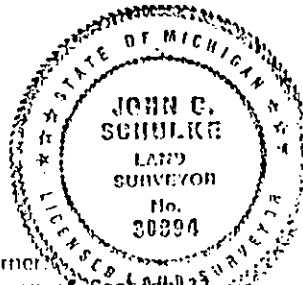

C Description of monument for corner and accessories established to perpetuate locating the position of the corner:

E-13 Pine stumps for Standard Corner of Sections 32 and 33 and the Closing corner of Sections 4 and 5 was inspected by Pat Leemon a surveyor of the U.S.F.S. Following consultation with Mr. Leemon and the Mason Co. Surveyors Peer Group with the evidence the corner was moved to the new position. Reset concrete monument by Griffin and stamped 1993-JS-RLS-30894 on the cap. Reset wood post with location tag West 1.19 ft. from the corner. The following corner references: W. Pine 15" N23°E 34.90 ft. W. Pine (old blaze) 18" S07°W 16.54 ft. W. Pine (old blaze & top dying) 14" S86°W 42.66 ft. Red Maple 7" N85°W 31.03 ft. Red Maple 5" N40°W 21.50 ft. (Pine stump of GLO bearing tree NW side of tree)

F-13 Pine stump for South Quarter corner of Section 33 was inspected by Pat Leemon a surveyor of the U.S.F.S. Following consultation with Mr. Leemon and the Mason Co. Surveyors Peer Group with the evidence the corner was moved to the new position. Reset concrete monument by Griffin and stamped 1993-JS-RLS-30894 on the cap. Reset wood post with location tag East 1.89 ft. from the corner. The following corner references: Red Oak (1983 blaze) 15" N67°E 38.14 ft. Red Oak (1983 blaze) 9" N52°E 63.21 ft. Red Oak (1983 blaze) 5" N23°E 39.81 ft. Red Oak (1993 blaze) 6" S40°W 64.59 ft. North 1/4 of Section 4, T19N, R15W, S89°54'E 12.62 ft.

Signed by John C. Schulke Surveyor's Michigan License No. RLS-30894

Date Nov 9, 1993

Date: 11-9-93 LIBER Mason County Surveyor

FORM APPROVED BY MICHIGAN STATE BOARD OF LAND SURVEYORS, JAN. 28, 1971 REVISED MAY 14, 1975 REVISED JAN. 1983

E-13 In 1940, Dykstehouse found wood stake and placed a location tag as the corner of Sections 4 and 5. No corner references.

In 1979, K. Ross found 3/4" iron rod and set a 1/2" rebar West 17.16 ft. No corner references.

In 1983, R. Griffin found 1/2" dia. X 24" rebar and replaced it with a 5" X 60" concrete monument with a brass cap (see corner certificate Book 2, page 158 in the Mason County Register of Deed's Office).

F-13 In 1983, R. Griffin replaced rebar with 5" X 60" concrete monument with a brass cap (see Corner Certificate Book 2, page 158 in the Mason County Register of Deed's Office).