

SURVEY & REMONUMENTATION

APR 28 1995

LAND CORNER RECORDATION CERTIFICATE

FILING REQUIREMENT OF ACT 74, MICH. P.A.1970

COMMISSION

FOR CORNERS OF-- LOCATED IN-- CORNER CODE NUMBER AT 10:10 O'CLOCK a M


1. PUBLIC LAND SURVEY T. 20N N. 15W E. G1
S., R. W.

2. PROPERTY CONTROLLING IN SECTION T. N. E. *Seg. 1*
S., R. W.

3. MISCELLANEOUS PROPERTY IN SECTION T. N. E.
S., R. W.

4. LOT NO. , RECORDED PLAT

5. PRIVATE CLAIMS

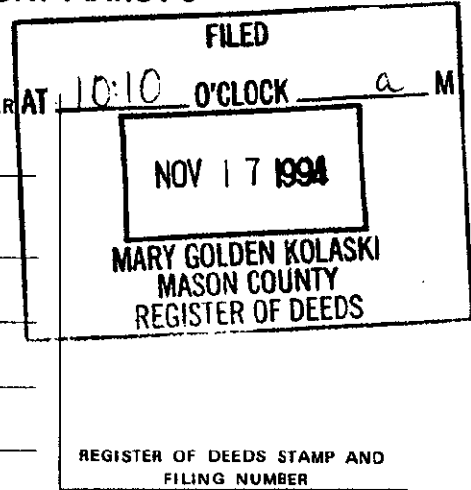

I, Patrick R. Leemon do hereby certify that under requirements of P.A. 74, Michigan P.A. of 1970, the corner points mentioned in lines 1 and 2 above (identified with circles on index code diagram - over) were, in a field survey on October 30 1994, established, re-established, monumented, re-monumented, recovered or restored as expressed below and in conformance with regulations and rules therefore as required in the current manual of survey instructions of the United States Department of the Interior, Bureau of Land Management or by a decree of a court of law. Furthermore, that the corner points mentioned in lines 3, 4 and 5 above were, in a field survey on _____ 19____, found, recovered, restored, established or re-established as expressed below and in conformance with the rules of the Michigan State Board of Registration for Land Surveyors or, by a Decree of a Court of law:

A. Description of original monument and accessories and/or subsequent restoration:

Closing section corner common to sections 3 and 4 of T20N R15W

1838 survey by Mullett & Brookfield
Set Wood Post
#1 P.Pine 8 S48E 310 links
#2 P.Pine 4 S4W 290 links

1956 survey by C. Dodt #2174
Found the conc. monu. by Mitchell
#5 W.Pine 14 S35E 12.5 feet
#6 Oak 5 N3E 20.5 feet

1918 survey by C.E. Mitchell
Set conc. monu. w/ 1" gas pipe
#3 Oak 12 S48E 18 links
#4 Oak 14 N87E 52 links

1972 survey by Robert A. Griffin 13584
Found the remains of the Mitchell monu. & replaced it w/ a 5" sq. by 36" long conc. monu. w/ 3" brass disk.
#7 W.Oak 5 N63E 63.65 feet
#6 R.Oak 7 S51E 139.44 feet
#8 P.Post 4 S45E 46.7 feet
#9 SW cor. sec. 35 T21N R15W
N89-41W 137.20 feet

B. Description of corner evidence found and/or method applied in restoring or re-establishing corner:


I found the 5" square by 36" long concrete monument w/ brass cap by Griffin buried 12" and raised with a 10" spike to the surface. It is in the intersection of the N-S-E & W roads. Witnesses 1 through 6 and 9 are gone. Witnesses 7, 8 and 10 are in good condition. Liber 1 Page 44 by Griffin documents the history of this corner. I could find no conflicting information that would lead to another location. A 1972, 1975 and 1976 survey by Clint Cole #17615 and the plat of "Little M Estates" used this location. This monument is accepted as a careful and faithful reestablishment of the position of the original corner.

C. Description of monument for corner and accessories established to perpetuate locating the position of the corner:

Closing section corner common to sections 3 and 4 of T20N R15W

Monu. The 5" square by 36" long concrete monu. with 3" brass disk was left in place

Witnesses: *RAISED THIS POSITION TO THE SURFACE W/ A 5/8" x 16" REBAR W/ ALUM. CAP AND ALSO PLACED A MONUMENT BOX.*
W.Pine 8 S74W 57.99 feet
Rebar 5/8" x 24" N34W 89.90 feet
P.Pole N85E 62.12 feet
W.Oak 9 N63E 63.66 feet (#7)
R.Oak 11 S51E 139.31 feet (#8)
SW 35 T21N R15W 5x60 conc. monu. N89-41W 137.42 feet (#10)

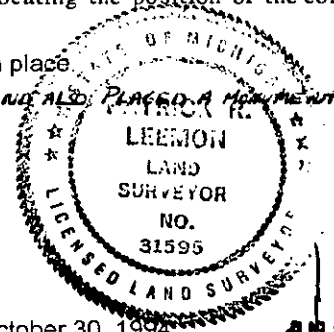

SIGNED BY Patrick R. Leemon DATE October 30, 1994
31595 (SEAL)

SURVEYOR'S MICHIGAN REGISTRATION NO. _____ (SEAL)

FOR STATE AND UNITED STATES AGENCIES:

SIGNED BY _____ DATE _____
CHIEF OF SURVEY PARTY

APPROVED AND SIGNED BY _____ DATE _____
MICHIGAN REGISTERED LAND SURVEYOR (SEAL)

Peer Group Review and Approved
Diane
Kenneth J. Ross
Mason County Surveyor