


**SURVEY &  
REMONUMENTATION  
LAND CORNER RECORDATION CERTIFICATE**

APR 28 1995 FILING REQUIREMENT OF ACT 74, MICH. P.A.1970

**COMMISSION**

<b>FOR CORNERS OF--:</b>	<b>LOCATED IN--:</b>	<b>CORNER CODE NUMBER</b>
1. PUBLIC LAND SURVEY _____ T. _____	20N N. 15W E. S. R. W.	G3
2. PROPERTY CONTROLLING IN SECTION _____, T. _____	N. E. S. R. W.	<i>Seg. 1</i>
3. MISCELLANEOUS PROPERTY IN SECTION _____, T. _____	N. E. S. R. W.	
4. LOT NO. _____, RECORDED PLAT _____		
5. PRIVATE CLAIMS _____		

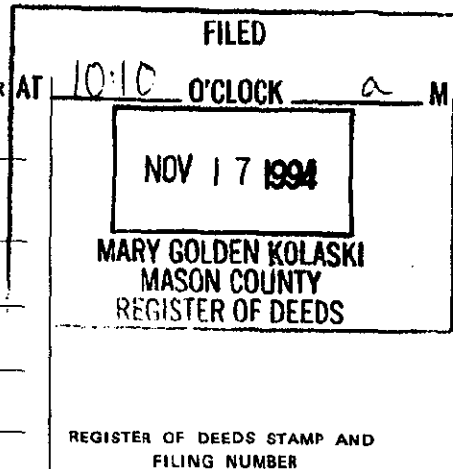

I, Patrick R. Leemon do hereby certify that under requirements of P.A. 74, Michigan P.A. of 1970, the corner points mentioned in lines 1 and 2 above (identified with circles on index code diagram - over) were, in a field survey on October 30 1994, established, re-established, monumented, re-monumented, recovered or restored as expressed below and in conformance with regulations and rules therefore as required in the current manual of survey instructions of the United States Department of the Interior, Bureau of Land Management or by a decree of a court of law. Furthermore, that the corner points mentioned in lines 3, 4 and 5 above were, in a field survey on \_\_\_\_\_ 19\_\_\_\_, found, recovered, restored, established or re-established as expressed below and in conformance with the rules of the Michigan State Board of Registration for Land Surveyors or, by a Decree of a Court of law:


- A. Description of original monument and accessories and/or subsequent restoration:
- |  |                                      |  |   |
|--|--------------------------------------|--|---|
| <b>Section corner common to sections 3, 4, 9 and 10 of T20N R15W</b> | <b>1839 survey by John Brink</b>     | <b>1918 survey by C.E. Mitchell Co. Sur.</b> | <b>1971 survey by Robert A. Griffin #13584</b>  |
|  | Set Wood Post                        | Set Concrete Monument                        | Searched for and found the concrete monument by Mitchell. Replaced it w/ a 5" sq. by 36" long conc. monument w/ 3" brass cap. |
|  | #1 P.Pine 4 S70W 620 links           | #3 W.Oak 10 N40W 189 links                   | #6 W.Oak 7 East 65.37 feet  |
|  | #2 P.Pine 3 N8W 552 links            | #4 B.Oak 12 N64E 226 links                   | #7 W.Oak 8 S39E 84.70 feet  |
|  | <b>1972 survey by C. Cole #17615</b> |  | #8 P.Post 4 West 2.17 feet  |
|  | Fd. Concrete monument                |  | #9 B.Oak 10 N52W 110.75 feet  |
|  | #5 E1/4 4 North 2649.20 feet         |  |   |

B. Description of corner evidence found and/or method applied in restoring or re-establishing corner:

I found the 5" square by 36" long concrete monument w/ brass cap by Griffin 12 feet West of the centerline of the N-S trail road. Witnesses 1, 2 and 8 are gone. Witness 4 is a stump. Witnesses 3, 6, 7 and 9 are in good condition. Liber 1 Page 153 by Griffin documents the history of this corner. I could find no conflicting information that would lead to another location. This monument is accepted as the best available evidence of the position of the original corner.

C. Description of monument for corner and accessories established to perpetuate location and position of the corner:

**Section corner common to sections 3, 4, 9 and 10 of T20N R15W**  
 Monu. The 5" square by 36" long concrete monu. with 3" brass disk was left in place.  
 Witnesses:  
 R.Pine 16 N44E 127.76 feet  
 Aspen 9 S61W 18.38 feet  
 W.Oak 23 N40W 125.51 feet (#3)  
 W.Oak 9 East 65.39 feet (#6)  
 W.Oak 12 S39E 84.73 feet (#7)  
 B.Oak 15 N52W 110.81 feet (#9)

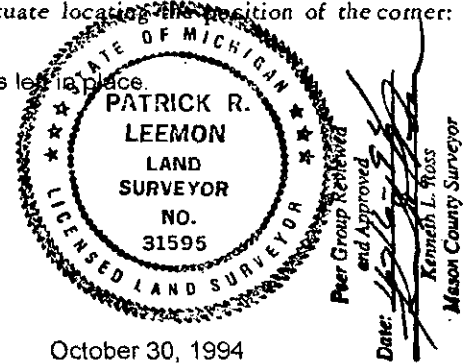

SIGNED BY Patrick R. Leemon DATE October 30, 1994  
 SURVEYOR'S MICHIGAN REGISTRATION NO. 31595 (SEAL)

FOR STATE AND UNITED STATES AGENCIES:  
 SIGNED BY \_\_\_\_\_ DATE \_\_\_\_\_  
 CHIEF OF SURVEY PARTY  
 APPROVED AND SIGNED BY \_\_\_\_\_ DATE \_\_\_\_\_  
 MICHIGAN REGISTERED LAND SURVEYOR (SEAL)

LIBER 3 PAGE 209