

SURVEY & REMONUMENTATION


MAY 07 1997

COMMISSION

LAND CORNER RECORDATION CERTIFICATE
Filing Requirement of Act 74, Mich. P.A. 1970

For corners in

MASON (County)	Located in:	Corner Code #
1. Public Land Survey	T 20N R 15W	G-9
	T R	
	T R	
	T R	
2. Property Controlling in Section	S T R	
	S T R	
3. Miscellaneous Property in Sec.	S T R	
	S T R	

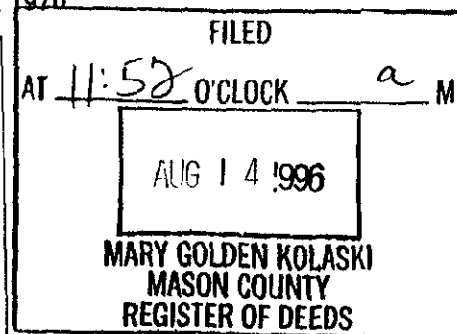

Register of Deeds Stamp & File Number

4. Lot No. _____, Recorded Plat _____
5. Private Claims _____

I, Sammy S. Barnett, in a field survey on July 23, 1996 do hereby state that under requirements of P.A. 74, Michigan P.A. of 1970, the corner points mentioned in lines 1 and 2 above were in conformance with regulations and rules therefore as required in the current manual of survey instructions of the United States Department of the Interior, Bureau of Land Management or by a decree of a Court of Law and /or that the corner points mentioned in lines 3, 4 and 5 above were in conformance with the rules of the Michigan Board of Land Surveyors or by a Decree of a Court of Law, established, re-established, monumented, recovered, found as expressed below:

NOTE: Not more than 2 corners, all in the same town and range, may be recorded on this certificate.

A	B	C	D	E	F	G	H	I	J	K	L	M
1												
2	6		5		4		3		2		1	
3												
4	7		8		9		10		11		12	
5												
6	18		17		16		15		14		13	
7												
8	19		20		21		22		23		24	
9												
10	30		29		28		27		26		25	
11												
12	31		32		33		34		35		36	
13												

A. Description of original monument and accessories and/or subsequent restoration:

G-9 Section Corner for Sections 21, 22, 27 and 28, T20N, R15W.

- | | | |
|---|---|--------------------------|
| 1839, John Brink, G.L.G.
Set Wood post | #4 White sign post North
16.5' | #8 Oak 24" N70°W 108.72' |
| #1 Beech 11" S33°E 531ks.34.98') | #5 Oak 12" NE 87.0' | #9 Rd. Sign S60°E 65.92' |
| #2 Beech 10" N28°W 431ks.(28.38') | #6 CCC Post SW 58.70' | |
| 1957, M.C.R.C.
3/4" Iron Pipe | 1975, Ken Ross, #17634
Set P. K. over Iron | |
| #3 Oak 15" NW 108.30' | #7 Post S45°W 55.38' | |

B. Description of corner evidence found and/or method applied in restoring or reestablishing corner:

G-9 Section Corner for Sections 21, 22, 27 and 28, T20N, R15W.

ON July 23, I Found a 1/2" Re-Rod over a 1" Iron Pipe, inside an existing monument box, 1 foot North of the center-line of Freesoil Road, I found no evidence to dispute this location for the corner.

Condition of recorded witnesses are;

- | | |
|----------------|---|
| #1 Gone | #6 Gone |
| #2 Gone | #7 Found in fair condition w/ USFS sign |
| #3 Found stump | #8 Same as 3 |
| #4 Gone | #9 Gone |
| #5 Found stump | |


C. Description of monument for corner and accessories established to perpetuate locating the position of the corner:

G-9 Section Corner for Sections 21, 22, 27 and 28, T20N, R15W.

I replaced 1/2" Re-Rod, in the exact location, with a Standard Mason County Monument, set inside an existing road monument box, and is accepted as a careful and faithful reestablishment of the position of the original corner.

- Red Oak 17" S 03° E 135.95'(60d spike in West side of tree)
- Black Oak 16" S 47° E 104.15'(60d spike in SW side of tree)
- Jack Pine 13" N 48° W 85.30'(60d spike in NE side of tree)
- Fence Post Pine N 64° E 77.88'(60d spike in SE side of post)

Signed by Sammy S. Barnett Date 8-12-96
Surveyor's Michigan License No. 16923

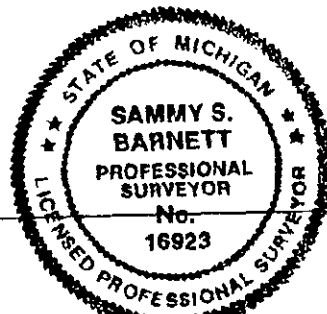

Peer Group Reviewed and Approved
Date: 8-13-96
Kenneth L. Ross
Mason County Surveyor

FORM APPROVED BY MICHIGAN STATE BOARD OF PROFESSIONAL SURVEYORS, JAN. 28, 1971
REVISED MAY 14, 1975
REVISED JAN., 1983
REVISED OCT., 1985