

SURVEY & REMONUMENTATION


JAN 21 1997

MAY 07 1997

LAND CORNER RECORDATION CERTIFICATE
Filing Requirement of Act 74, Mich. P.A. 1970

For corners in **COMMISSION**

MASON (County)	Located In:	Corner Code #
1. Public Land Survey	T 20N R 15W	G-10
	T R	
	T R	
	T R	
2. Property Controlling In Section	S T R	
	S T R	
3. Miscellaneous Property in Sec.	S T R	
	S T R	

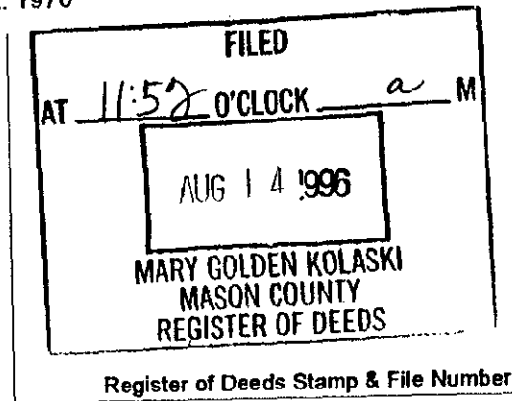

4. Lot No. _____, Recorded Plat _____
5. Private Claims _____

I, Sammy S. Barnett, in a field survey on July 23, 1996 do hereby state that under requirements of P.A. 74, Michigan P.A. of 1970, the corner points mentioned in lines 1 and 2 above were in conformance with regulations and rules therefore as required in the current manual of survey instructions of the United States Department of the Interior, Bureau of Land Management or by a decree of a Court of Law and /or that the corner points mentioned in lines 3, 4 and 5 above were in conformance with the rules of the Michigan Board of Land Surveyors or by a Decree of a Court of Law; established, re-established, monumented, recovered, found as expressed below:

1	A	B	C	D	E	F	G	H	I	J	K	L	M
2		6		5		4		3		2		1	
3													
4		7		8		9		10		11		12	
5													
6		10		11		16		15		14		13	
7													
8		19		20		21		22		23		24	
9													
10		30		29		28		27		26		25	
11													
12		31		32		33		34		35		36	
13													

NOTE: Not more than 2 corners, all in the same town and range, may be recorded on this certificate.

A. Description of original monument and accessories and/or subsequent restoration:

G-10 1/4 Corner for Sections 27 and 28, T20N, R15W.

1839, John Brink, G.L.O.

Set Wood Post

#1 Beech 10" N24°W 531ks.(34.98')

#2 Beech 11" S00½°E 331ks.(21.78')

#3 Jack Pine 8" S80°E 24.35'

#4 Jack Pine 10" S10°E 54.56'

#5 Red Pine 8" West 48.26'

Center-line Road 13' West

1976, Ken Ross, #17634

Set 1/2" Re-rod, @ single proportional Method. (cont.)

B. Description of corner evidence found and/or method applied in restoring or reestablishing corner:

G-10 1/4 Corner for Sections 27 and 28, T20N, R15W.

On July 23, I found a 1/2" Re-rod with RLS cap #17634, 13 feet East of the center-line of Campbell Road I found no evidence to dispute this location for the corner.

Condition of the recorded witnesses are;

#1 Gone

#5 Found in good condition

#2 Gone

#3 Found in good condition

#4 Found in good condition

C. Description of monument for corner and accessories established to perpetuate locating the position of the corner:

G-10 1/4 Corner for Section 27 and 28, T20N, R15W.

I replaced 1/2" Re-rod, in the exact location, with a Standard Mason County Monument, placed 0.8' below road surface (dirt), and is accepted as a careful and faithful reestablishment of the position of the original corner.

(ext. BT #3) Jack Pine 10" S 80° E 24.35'(60d spike in SW side of tree)


(ext. BT #4) Jack Pine 12" S 10° E 54.56'(60d spike in West side of tree)

(ext. BT #5) Red Pine 10" West 48.26'(60d spike in North side of tree)

White Pine 12" N 80° W 60.30'(60d spike in NE side of tree)

Signed by Sammy S. Barnett
Surveyor's Michigan License No. 16923

Date 8-17-96

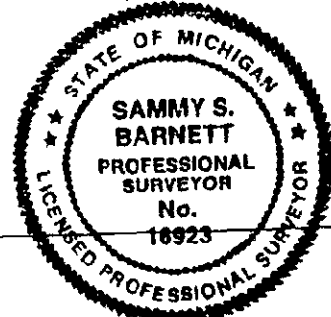

Peer Group Reviewed and Approved
Date: 8-13-96
Kenneth L. Ross
Mason County Surveyor

FORM APPROVED BY MICHIGAN STATE BOARD OF PROFESSIONAL SURVEYORS, JAN. 28, 1971
REVISED MAY 14, 1975
REVISED JAN., 1983
REVISED OCT., 1995