

**SURVEY & REMONUMENTATION**


OCT 29 1996

COMMISSION

**LAND CORNER RECORDATION CERTIFICATE**  
Filing Requirement of Act 74, Mich. P.A. 1970

For corners in

MASON (County)	Located in:	Corner Code #
1. Public Land Survey	T20N R15W	H-9
	T R	
	T R	
	T R	
2. Property Controlling in Section	S T R	
	S T R	
3. Miscellaneous Property in Sec.	S T R	
	S T R	

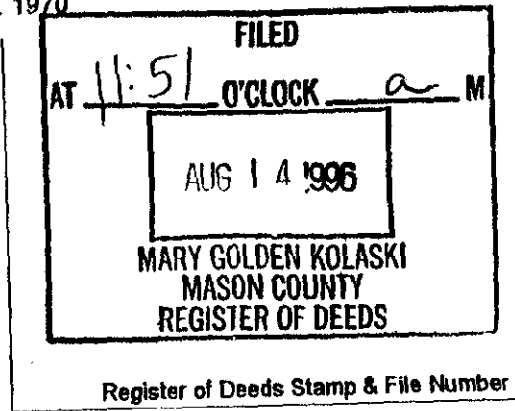

- 4. Lot No. \_\_\_\_\_, Recorded Plat \_\_\_\_\_
- 5. Private Claims \_\_\_\_\_

I, Sammy S. Barnett, in a field survey on July 23, 1996 do hereby state that under requirements of P.A. 74, Michigan P.A. of 1970, the corner points mentioned in lines 1 and 2 above were in conformance with regulations and rules therefore as required in the current manual of survey instructions of the United States Department of the Interior, Bureau of Land Management or by a decree of a Court of Law and/or that the corner points mentioned in lines 3, 4 and 5 above were in conformance with the rules of the Michigan Board of Land Surveyors or by a Decree of a Court of Law; established, re-established, monumented, recovered, found as expressed below:

NOTE: Not more than 2 corners, all in the same town and range, may be recorded on this certificate.

	A	B	C	D	E	F	G	H	I	J	K	L	M
1													
2	6	5	4	3	2	1							
3													
4	7	8	9	10	11	12							
5													
6	10	17	16	15	14	13							
7													
8	19	20	21	22	23	24							
9													
10	30	29	28	27	26	25							
11													
12	31	32	33	34	35	36							
13													

**A. Description of original monument and accessories and/or subsequent restoration:**

H-9 1/4 Corner for Sections 22 and 27, T20N, R15W.

1839, John Brink, G.L.O.

Set Wood Post

- #1 Hemlock 9" S31°E 40lks.(26.40')
- #2 White Oak 10" N30°W 52lks.(34.32')

1976, Ken Ross, #17634

RailRoad Spike 3' South of C-L

- #3 Cherry 6" S15°E 33.20'
- #4 Tw. R. Pine 10" S50°W 55.24'
- #5 W. Oak 8" N20°W 34.66'

**B. Description of corner evidence found and/or method applied in restoring or reestablishing corner:**

H-9 1/4 Corner for Sections 22 and 27, T20N, R15W.

On July 23, I found a RailRoad Spike 3.5 feet South of the center-line of Freesoil Road, I found no evidence to dispute this location for the corner. Also located a fence line to the South.

Condition of recorded witnesses are;

- #1 Gone
- #2 Gone
- #3 Found (dead)
- #4 Found (dead)
- #5 Found in good condition

**C. Description of monument for corner and accessories established to perpetuate locating the position of the corner:**


H-9 1/4 corner for Sections 22 and 27, T20N, R15W.

I replaced RailRoad Spike, in the exact location, with a Standard Mason County Monument, also set a new road monument box, and is accepted as a careful and faithful reestablishment of the position of original corner.

- (ext. BT #5) White Oak 16" N 20° W 34.70'(60d spike in SW side of tree)
- Red Oak 5" S 26° E 57.70'(60d spike in NE side of tree)
- Black Oak 9" N 48° E 59.76'(60d spike in SE side of tree)
- White Oak 9" N 36° W 77.18'(60d spike in SW side of tree)

Signed by Sammy S. Barnett  
Surveyor's Michigan License No. 16923

Date 8-17-96

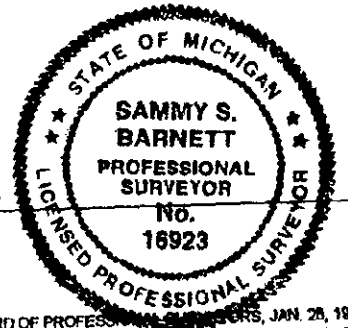

Peer Group Reviewed and Approved.  
Date: 8-13-96  
Kenneth L. Hess  
Mason County Surveyor

FORM APPROVED BY MICHIGAN STATE BOARD OF PROFESSIONAL SURVEYORS, JAN. 28, 1971  
REVISED MAY 14, 1975  
REVISED JAN., 1983  
REVISED OCT., 1985