

MAR 06 1993

COMMISSION

LAND CORNER RECORDATION CERTIFICATE
Filing Requirement of Act 74, Mich. P.A. 1970


For corners in

MASON
(County)

Located In:

Corner Code //

- 1. Public Land Survey T 20N R 15W
T 20N R 15W
T 20N R 15W
T R
- 2. Property Controlling S T R
in Section S T R
- 3. Miscellaneous S T R
Property in Sec. S T R

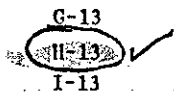

FILED

AT 10:45 O'CLOCK Gi M

NOV 11 1993

MARY GOLDEN KOLASKI
MASON COUNTY
REGISTER OF DEEDS

Register of Deeds Stamp & File Number

- 4 Lot No. _____, Recorded Plat _____
- 5 Private Claims _____

	A	B	C	D	E	F	G	H	I	J	K	L	M
2		6		5		4		3		2		1	
3													
4		7		8		9		10		11		12	
5													
6		15		17		16		15		14		13	
7													
8		19		20		21		22		23		24	
9													
10		30		29		28		27		26		25	
11													
12		31		32		33		34		35		36	
13													

1. John Schulke in a field survey on Oct. 22nd & 25th, 1993
do hereby certify that under requirements of P.A. 74, Michigan P.A. of 1970, the corner points mentioned in lines 1 and 2 above were in conformance with regulations and rules therefore as required in the current manual of survey instructions of the United States Department of the Interior, Bureau of Land Management or by a decree of a Court of Law and/or that the corner points mentioned in lines 3, 4 and 5 above were in conformance with the rules of the Michigan Board of Land Surveyors or by a Decree of a Court of Law; established, re-established, monumented, re-monumented, recovered, found as expressed below:

NOTE: Not more than 4 corners, all in the same town and range, may be recorded on this certificate.

A. Description of original monument and accessories and/or subsequent restoration:

G-13
Original survey established in 1838 by Mullett. Set a wooden post with the following references:
Beech 7" N48°E 13 lks.
Cedar 8" N21°W 16 lks.
In 1838, Sibley established Closing Corner to Sections 3 and 4, T19N, R15W, 17 lks. East of Standard Corner post a 12" dia. Cedar tree as the corner. CONTINUE ON BACK

H-13
Original survey established in 1838 by Mullett. Set a wooden post with the following references:
Hemlock 12" N50°E 20 lks.
Hemlock 12" N45°W 23 lks.


I-13
Original survey established in 1838 by Mullett. Set a wooden post with the following references:
Hemlock 10" N50°E 16 lks.
Tamarack 10" N20°W 28 lks.
In 1838, Sibley established Closing Corner to Sections 2 and 3, T19N, R15W, 29 lks. East of Standard Corner post a 9" dia. Cedar tree as the corner. CONTINUE ON BACK

B Description of corner evidence found and/or method applied in restoring or reestablishing corner:

G-13
No evidence found. From proportional position between F-13 (S 1/4 corner of Section 33) and I-13 (SE Section corner of Section 34). Swamp North 70 ft. and a stream North 250 ft. which flows South-West.

H-13
No evidence found. Area been disturbed by an old railroad grade.

I-13
Found 1" X 26" Iron pipe and found the following bearing trees:
Hemlock 16" tag S10°E 83.03 ft.
Hemlock 9" tag N65°E 57.89 ft.

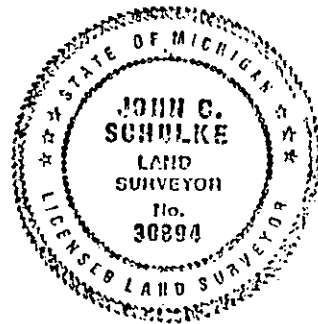

C Description of monument for corner and accessories established to perpetuate locating the position of the corner:

G-13
Accepted single proportional measurement as the best available method to reestablish the GLO corner. Set 2 1/2" dia. X 30" iron pipe with a brass cap stamped to identify the corner. South 1/4 corner of Section 33 is S89°54'04"W a distance of 2638.16 feet. The Southeast corner CONTINUE ON BACK

H-13
Accepted proportional position as the best available method to reestablish the GLO corner. Set a 2 1/2" dia. X 30" iron pipe with a brass cap stamped to identify the corner. Southeast corner of Section 34 (I-13) is S89°54'04"E a distance of 2638.16 feet. The CONTINUE ON BACK

I-13
Accepted the iron pipe as the best available evidence as to the position of the GLO corner. Replaced with a 2 1/2" dia. X 30" iron pipe with a brass cap stamped to identify the corner. Fiberglass post set 1.8 ft. East of the the corner. Closing corner to Sections 2 & 3 bears S89°34'E a distance of 18.92 feet. CONTINUE ON BACK

Signed by John C. Schulke
Surveyor's Michigan License No. RLS-30894

Date Nov 9, 1993

Date: 4-9-93
[Signature]
Mason County Surveyor

G-13 continued column "A"
 In 1838, Hogenson ran a line North
 Between Sections 33 and 34.
 1.00 chains enter swamp
 3.00 chains Stream 75 lks. wide
 flows Northwest.

I-13 continued column "A"
 In 1983, R. Griffin filed a Land Corner
 Recordation Certificate (see Liber 2,
 page 161) indicates 5" X 60" concrete
 monument with a brass cap stamped for
 Closing Corner of Sections 2 and 3
 (T19N, R15W) bears East 18.91 feet.

G-13 continued column "C"
 of Section 34 bears S89°54'04"E
 a distance of 5276.31 feet. The
 Closing Corner to Sections 3 & 4
 bears S89°54'E a distance of 11.22
 Set a fiberglass post 1.6 ft. West
 of the corner. The following corner
 references:

R Oak	10"	N43°W	9.42 ft.
R Maple	6"	S44°W	17.68 ft.
W Oak	8"	S17°E	38.65 ft.
R Maple	7"	N18°W	56.72 ft.

H-13 continued column "C"
 Southwest corner of Section 34 (G-13)
 N89°54'04"W a distance of 2638.16 feet.
 The North 1/4 corner of Section 3 bears
 S89°54'E a distance of 15.07 feet. The
 a fiberglass post 1.8 ft. West of corner.
 The following corner references:

R Oak	8"	S14°E	35.89 ft.
R Maple	12"	N16°W	33.87 ft.
W Oak	8"	S87°W	28.93 ft.
R maple	13"	N58°W	36.97 ft.

I-13 continued column "C"
 The following corner references:

Hemlock (old blaze)	16"	N06°W	38.12 ft
Hemlock (old blaze)	9"	N65°E	57.89 ft
Hemlock	5"	S33°W	23.36 ft
Cedar	5"	N28°W	32.07 ft