

DEC 18 1995
COMMISSION

LAND CORNER RECORDATION CERTIFICATE

FILING REQUIREMENT OF ACT 74, MICH. P.A. 1970

FOR CORNERS OF -- LOCATED IN --

1. PUBLIC LAND SURVEY _____ T. 20N N. 15W E. S., R. _____ W.

2. PROPERTY CONTROLLING IN SECTION _____ T. _____ N. S., R. _____ E. W.

3. MISCELLANEOUS PROPERTY IN SECTION _____ T. _____ N. S., R. _____ E. W.

4. LOT NO. _____, RECORDED PLAT _____

5. PRIVATE CLAIMS _____

CORNER CODE NUMBER
K2

FILED

AT 10:24 O'CLOCK a M

OCT 18 1995

MARY GOLDEN KOLASKI
MASON COUNTY
REGISTER OF DEEDS

REGISTER OF DEEDS STAMP AND FILING NUMBER

I, Patrick R. Leemon do hereby certify that under requirements of P.A. 74, Michigan P.A. of 1970, the corner points mentioned in lines 1 and 2 above (identified with circles on index code diagram -- over) were, in a field survey on October 15, 1995, established, re-established, monumented, re-monumented, recovered or restored as expressed below and in conformance with regulations and rules therefore as required in the current manual of survey instructions of the United States Department of the Interior, Bureau of Land Management or by a decree of a court of law. Furthermore, that the corner points mentioned in lines 3, 4 and 5 above were, in a field survey on _____ 19____, found, recovered, restored, established or re-established as expressed below and in conformance with the rules of the Michigan State Board of Registration for Land Surveyors or, by a Decree of a Court of law:

A. Description of original monument and accessories and/or subsequent restoration:

1/4 corner common to sections 1 and 2 of T20N R15W

- 1839 survey by John Brink Set Wood Post, (1) Hemlock 11 S28W 40 links, (2) Hemlock 10 N29E 28 links
- 1932 survey by W. H. Read Mason County Surveyor (3) Hemlock 10 N66W 45.9 ft., (4) Beech 15 S64 1/4 E 67.0 ft., NW 1 North 4120.0 ft., SW 1 South 2761.6 ft.
- 1978 survey by Sam Barnett #16923 Fd. Iron, (5) Cedar 6 N62W 15.78 ft., (6) Maple 4 N58E 32.69 ft., (7) Cedar 6 S60W 11.94 ft., (8) Pine Post 4 North 1.5 ft., NE 2 N0-01-43E 4118.44 ft., SE 2 S0-36-38E 2746.56 ft.

B. Description of corner evidence found and/or method applied in restoring or re-establishing corner:

I found the 1" by 60" long iron pipe, off an extension of a 2-track to the north, in good condition, extending 2 feet above the ground. I drove it 6 inches beneath the surface and set a 2"x30" iron pipe with brass cap over it and flush with the ground. The north edge of the cedar swamp is 20 feet north and the east edge is 20 feet east. Witnesses 1 and 2 are gone. Witness 4 is hollow but alive and 5 through 8 are in good condition. I could find no conflicting information that would lead to another location. This monument is accepted as a careful and faithful perpetuation of the position of the original corner.

C. Description of monument for corner and accessories established to perpetuate locating the position of the corner:

1/4 corner common to sections 1 and 2 of T20N R15W

Monu. Set a 2"x30" iron pipe with brass cap

Witnesses:

- 10" spike in the southeast side of a W.Cedar 7 S62W 11.85 ft. (7)
- 10" spike in the southwest side of a W.Cedar 11 N60W 15.63 ft. (5)
- 10" spike in the southeast side of a R.Maple 9 N63E 32.74 ft. (6)
- Pine Post 4 North 1.36 ft.
- 60d in the northeast side of a Hemlock 13 N65W 45.86 ft. (3)
- 60d in the southwest side of a Beech 22 S63E 67.39 ft. (4)
- 60d in the southwest side of a R.Maple 9 S63E 44.29 ft.

Peer Group Reviewed and Approved

Date: 10-21-95

Kenneth L. Ross
Mason County Surveyor


SIGNED BY Patrick R. Leemon DATE October 15, 1995

SURVEYOR'S MICHIGAN REGISTRATION NO. 31595

FOR STATE AND UNITED STATES AGENCIES:

SIGNED BY _____ DATE _____

APPROVED AND SIGNED BY _____ DATE _____

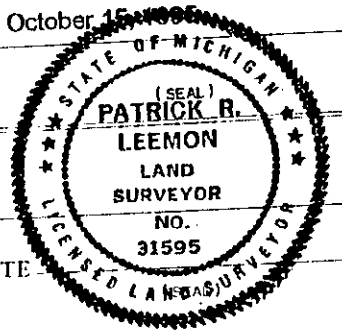

LIBER **3PAGE 318**

SURVEYOR'S MICHIGAN REGISTRATION NO. _____