

SURETY A
MEMORANDUM

DEC 18 1995

COMMISSIONER LAND CORNER RECORDATION CERTIFICATE

FILING REQUIREMENT OF ACT 74, MICH. P.A.1970

FOR CORNERS OF --: LOCATED IN --: CORNER CODE NUMBER

1. PUBLIC LAND SURVEY T. 20N N. 15W E. M4
S. R. W.

2. PROPERTY CONTROLL- N. E.
ING IN SECTION T. S. R. W.

3. MISCELLANEOUS N. E.
PROPERTY IN SECTION T. S. R. W.

4. LOT NO. , RECORDED PLAT

5. PRIVATE CLAIMS

FILED

AT 10:03 O'CLOCK a M

OCT 18 1995

MARY GOLDEN KOLASKI
MASON COUNTY
REGISTER OF DEEDS

REGISTER OF DEEDS STAMP AND
FILING NUMBER

I, Patrick R. Leemon do hereby certify that under requirements of P.A. 74, Michigan P.A. of 1970, the corner points mentioned in lines 1 and 2 above (identified with circles on index code diagram - over) were, in a field survey on October 15, 1995, established, re-established, monumented, re-monumented, recovered or restored as expressed below and in conformance with regulations and rules therefore as required in the current manual of survey instructions of the United States Department of the Interior, Bureau of Land Management or by a decree of a court of law. Furthermore, that the corner points mentioned in lines 3, 4 and 5 above were, in a field survey on 19, found, recovered, restored, established or re-established as expressed below and in conformance with the rules of the Michigan State Board of Registration for Land Surveyors or, by a Decree of a Court of law:

A. Description of original monument and accessories and/or subsequent restoration:

1/4 corner common to section 12 of T20N R15W and section 7 of T20N R14W
 1838 survey by Mullett & Brookfield Set Post, (1) Y.Pine 18 S40W 25 links, (2) Y.Pine 18 N51W 65 links
 1907 survey by J. H. Millard Stake and found both GLO BT's, (3) J.Pine 6 N40E 16 ft., (4) J.Pine 9 N40W 9.5 ft.
 1915 survey by George H. Johnson #504 1"x28" round iron, same witnesses as Millard
 1974 survey by Clinton E. Cole #17615 Fd. 3/4" Iron Pipe, (5) B.Oak 10 S33E 21.38 ft., (6) R.Pine 8 N50W 24.53 ft.
 1974 survey by Robert A. Griffin #13584 LCRC Liber 2 Page 287, Replaced the 3/4" Iron Pipe with a 5"x60" concrete monu. w/brass cap, (7) R.Pine 5 N42E 27.01 ft., (5) B.Oak 10 S33E 21.38 ft., (8) Pine Post 7 East 1.9 ft., (9) R.Pine 6 S85W 23.75 ft., (6) R.Pine 8 N50W 24.53 ft.
 1984 survey by Dennis W. Dunlap #221759 Conc. Monument, same witnesses as Griffin,
 NE 12 N2-37-56W 2635.11 ft., SE 12 S2-28-46E 2640.21 ft.

B. Description of corner evidence found and/or method applied in restoring or re-establishing corner:

I found the 5" square by 60" long concrete monument w/ brass cap by Griffin extending 17" above the surface and in good condition, 600 feet more or less north of a SW-NE road and on the south edge of a R.Pine plantation. Witnesses 1 through 4 are gone. Witness 5 is dead. Witnesses 6 through 9 are in good condition. The GLO calls do not aid in recovery of this corner. I could find no conflicting information that would lead to another location. This monument is accepted as the best available evidence of the position of the original corner.

C. Description of monument for corner and accessories established to perpetuate locating the position of the corner:

1/4 corner common to section 12 of T20N R15W and section 7 of T20N R14W
 Monu. The 5" square by 60" long concrete monu. with 3" brass disk was left in place.

Witnesses:

- 60d nail in the southwest side of a R.Pine 11 N51W 24.61 ft. (6)
- 10" spike in the northwest side of a R.Pine 9 N42E 26.99 ft. (7)
- 10" spike in the north side of a R.Pine 10 S85W 23.74 ft.
- 60d nail in the southwest side of a W.Oak 8 S31E 34.68 ft.
- Pine Post 4 East 1.81 ft. (8)

Peer Group Reviewed
and Approved
Date: 10-15-95
Kenneth L. Ross
Mason County Surveyor


SIGNED BY Patrick R. Leemon DATE October 15, 1995

SURVEYOR'S MICHIGAN REGISTRATION NO. 31595

FOR STATE AND UNITED STATES AGENCIES:

SIGNED BY _____ DATE _____
CHIEF OF SURVEY PARTY

APPROVED AND SIGNED BY _____ DATE _____
MICHIGAN REGISTERED LAND SURVEYOR

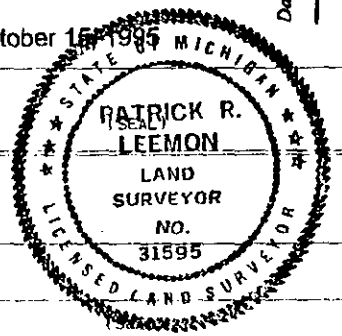

LIBER 3 PAGE 316

SURVEYOR'S MICHIGAN REGISTRATION NO. _____