

MAR 16 1998

SECTION

LAND CORNER RECORDATION CERTIFICATE


Filing Requirement of Act 74, Mich. P.A. 1970

For corners in MASON Located In: _____ Corner Code # _____
 (County)

1. Public Land Survey T 20N R 15W M-7
 T _____
 T _____
 T _____

2. Property Controlling S _____
 In Section S _____
 Property In Sec. S _____

4. Lot No. _____, Recorded Plat _____
 5. Private Claims _____

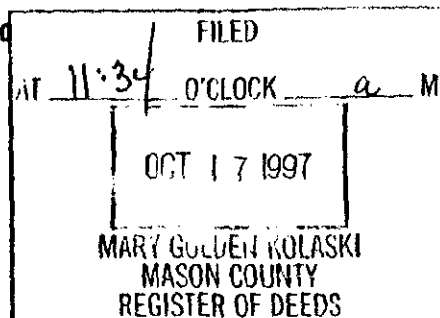

Register of Deeds Stamp & File Number

| | A | B | C | D | E | F | G | H | I | J | K | L | M |
|----|----|----|----|----|----|----|---|---|---|---|---|---|---|
| 1 | | | | | | | | | | | | | |
| 2 | 6 | 5 | 4 | 3 | 2 | 1 | | | | | | | |
| 3 | | | | | | | | | | | | | |
| 4 | 7 | 8 | 9 | 10 | 11 | 12 | | | | | | | |
| 5 | | | | | | | | | | | | | |
| 6 | 18 | 17 | 16 | 15 | 14 | 13 | | | | | | | |
| 7 | | | | | | | | | | | | | |
| 8 | 19 | 20 | 21 | 22 | 23 | 24 | | | | | | | |
| 9 | | | | | | | | | | | | | |
| 10 | 30 | 29 | 28 | 27 | 26 | 25 | | | | | | | |
| 11 | | | | | | | | | | | | | |
| 12 | 31 | 32 | 33 | 34 | 35 | 36 | | | | | | | |
| 13 | | | | | | | | | | | | | |

I, Kenneth L. Ross, in a field survey on September 12, 1997, do hereby certify that under requirements of P.A. 74, Michigan P.A. of 1970, the corner points mentioned in lines 1 and 2 above were in conformance with regulations and rules therefore as required in the current manual of survey instructions of the United States Department of the Interior, Bureau of Land Management or by a decree of a Court of Law and/or that the corner points mentioned in lines 3, 4 and 5 above were in conformance with the rules of the Michigan Board of Land Surveyors or by a Decree of a Court of Law; established, re-established, monumented, re-monumented, recovered, found as expressed below:

NOTE: Not more than 4 corners, all in the same town and range, may be recorded on this certificate.

A. Description of original monument and accessories and/or subsequent restoration:

M-7 Northeast Corner for Section 24, T20N, R15W, on the Township Line.

1838, Mullett & Brookfield, GLO boundary survey
 Set Wood Post
 #1 White Pine 30" N 48° W 1051ks. (69.30')
 #2 White Oak 12" S 22° W 941ks. (62.04')

1981, Robert A. Griffin, RLS # 13584
 Set 5" sq. x 36" concrete monument with 3" brass cap. Recovered this corner by proportional measurement and on a straight line between controlling corners. L. 02, p. 437, Lake Co.
 #3 White Pine 12" N 37° W 61.76'
 #4 Red Pine 10" N 66° E 51.57'
 #5 White Pine 9" S 68° E 73.33'
 #6 Cedar Post 6" West 1.70'

B. Description of corner evidence found and/or method applied in restoring or reestablishing corner:

M-7 Northeast Corner for Section 24, T20N, R15W, on the Township Line.

On September 12, 1997, I Ken Ross and Kevin Pritchard (survey tech.) found 5" square conc. monument with 3" brass cap, stamped to identify this monument as the corner, I found this corner by Griffin in West Road ditch 0.5 foot below the ground surface. I found no other evidence to dispute this location for this section corner.


Condition of recorded witnesses are: #1 gone #2 gone #3 Found in good condition
 #4 Found in good condition #5 Found in good condition #6 Found in good condition

C. Description of monument for corner and accessories established to perpetuate locating the position of the corner:

M-7 Northeast Corner for Section 24, T20N, R15W, on the Township Line.

I accepted Griffin's 5" square concrete monument, with 3" brass cap as a substantial marker for this corner and is accepted as a careful and faithful re-establishment of the position of the original corner.

(ext. BT #3) White Pine 22" N 37° W 61.76' (10" dock spike in SW side of tree)
 (ext. BT #4) Red Pine 18" N 66° E 51.57' (10" dock spike in NW side of tree)
 (ext. BT #5) White Pine 17" S 68° E 73.33' (10" dock spike in NE side of tree)
 (new BT) White Oak 18" S 37° W 40.00' (60d spike in NW side of tree)

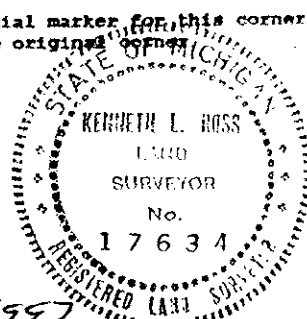

Signed by Kenneth L. Ross
 Surveyor's Michigan License No. 17634

Date October 1, 1997

FORM APPROVED BY MICHIGAN STATE BOARD OF LAND SURVEYORS, JAN. 26, 1974
 REVISED MAY 14, 1975
 REVISED JAN. 1982
 ADAPTED FOR WORD PROCESSING MARCH, 1982

LIBER 4 PAGE 112

Peer Group Reviewed and Approved
 Date: Oct 2, 1997
Kenneth L. Ross
 Mason County Surveyor