

MAR 16 1998

LAND CORNER RECORDATION CERTIFICATE

SECTION

Filing Requirement of Act 74, Mich. P.A. 1970

For corners in MASON (County) Located In: _____ Corner Code # _____

1. Public Land Survey T 20N R 15W M-9
 T _____ R _____
 T _____ R _____
 T _____ R _____

2. Property Controlling In Section S _____ T _____ R _____
 S _____ T _____ R _____

3. Miscellaneous Property in Sec. S _____ T _____ R _____
 S _____ T _____ R _____

4. Lot No. _____ Recorded Plat _____

5. Private Claims _____

FILED AT 11:35 O'CLOCK a.m.

OCT 17 1997

MARY GOLDEN KOLASKI
 MASON COUNTY
 REGISTER OF DEEDS

Register of Deeds Stamp & File Number

I, Kenneth L. Ross, in a field survey on September 12 19 97, do hereby certify that under requirements of P.A. 74, Michigan P.A. of 1970, the corner points mentioned in lines 1 and 2 above were in conformance with regulations and rules therefore as required in the current manual of survey instructions of the United States Department of the Interior, Bureau of Land Management or by a decree of a Court of Law and/or that the corner points mentioned in lines 3, 4 and 5 above were in conformance with the rules of the Michigan Board of Land Surveyors or by a Decree of a Court of Law; established, re-established, monumented, re-monumented, recovered, found as expressed below.

	A	B	C	D	E	F	G	H	I	J	K	L	M
1													
2	6	5	4	3	2	1							
3													
4	7	8	9	10	11	12							
5													
6	18	17	16	15	14	13							
7													
8	19	20	21	22	23	24							
9													
10	30	29	28	27	26	25							
11													
12	31	32	33	34	35	36							
13													

NOTE: Not more than 4 corners, all in the same town and range, may be recorded on this certificate.

A. Description of original monument and accessories and/or subsequent restoration:
 M-9 East 1/4 Corner for Section 24, T20N, R15W, on the Township Line,

1838, Mullett & Brookfield, GLO, boundary survey
 Used 12" Hemlock for corner.


1974, Robert A. Griffin, RLS # 13584
 Set 5" sq. x 36" conc. monument w/ 3" brass cap
 #1 Maple 8" S 52° E 57.33'
 #2 Maple 14" N 45° W 51.22'
 #3 Cedar 7" S 72° W 112.10'
 #4 Maple 12" S 03° W 37.08'
 #5 Pine post South 33.43'
 Griffin Found monument by County Road Comm, and used for corner location as of L. 02, P. 276, Lake Co. Register of Deeds.

B. Description of corner evidence found and/or method applied in restoring or reestablishing corner:

M-9 East 1/4 Corner for Section 24, T20N, R15W, on the Township Line.

On September 12, 1997, I Ken Ross and Kevin Pritchard (survey tech.) found 5" square concrete monument, with 3" brass cap, stamped to identify the section corner, found this corner by Griffin 3 feet North of the center-line of Freesoil Road, just below the surface of paved road. I found no other evidence to dispute the location of this for the corner location. Note this corner fits G.L.O. stream call to the West, with a 1/2 chain.

Condition of recorded witnesses are:
 #1 Found stump, tree cut by power company #2 Found in good condition
 #3 Found in good condition #4 Found in good condition #5 Found in good condition

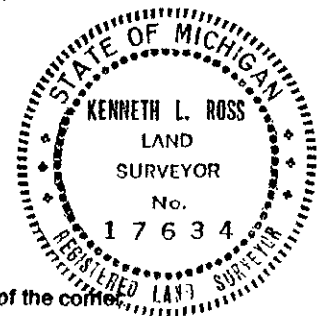

C. Description of monument for corner and accessories established to perpetuate locating the position of the corner:

M-9 East 1/4 Corner for Section 24, T20N, R15W, on the Township Line.

I accepted 5" square x 36" concrete monument by Griffin as a substantial marker for this corner and is accepted as a careful and faithful re-establishment of the position of the original corner.

- (ext. BT #2) Maple 20" N 45° W 51.22' (10" dock spike in NE side of tree)
- (ext. BT #3) Cedar 14" S 72° W 112.10' (10" dock spike in SE side of tree)
- (ext. BT #4) Maple 18" S 03° W 37.08' (10" dock spike in east side of tree)
- (new BT) Cedar 20" S 67° E 95.55' (60 d spike in Sw side of tree)

Signed by Kenneth L. Ross Date October 1, 1997
 Surveyor's Michigan License No. 17634

Peer Group Reviewed and Approved
 Date: Oct. 2, 1997
Kenneth L. Ross
 Mason County Surveyor

FORM APPROVED BY MICHIGAN STATE BOARD OF LAND SURVEYORS, JAN. 28, 1971
 REVISED MAY 14, 1975
 REVISED JAN. 1983
 ADAPTED FOR WORD PROCESSING MARCH, 1993