

MAR 16 1998

LAND CORNER RECORDATION CERTIFICATE

SECTION

FILING REQUIREMENT OF ACT 74, MICH. P.A.1970

FOR CORNERS OF--:	LOCATED IN--:	CORNER CODE NUMBER
1. PUBLIC LAND SURVEY _____	T. 20N N. 15W E. S., R. W.	E2
2. PROPERTY CONTROLLING IN SECTION _____	T. _____ N. S., R. W.	<i>Seg. 2</i>
3. MISCELLANEOUS PROPERTY IN SECTION _____	T. _____ N. S., R. W.	
4. LOT NO. _____, RECORDED PLAT _____		
5. PRIVATE CLAIMS _____		

FILED AT 10:10 O'CLOCK a

NOV 17 1998

MARY GOLDEN KOLASKI
MASON COUNTY
REGISTER OF DEEDS

REGISTER OF DEEDS STAMP AND FILING NUMBER

I, Patrick R. Leemon do hereby certify that under requirements of P.A. 74, Michigan P.A. of 1970, the corner points mentioned in lines 1 and 2 above (identified with circles on index code diagram - over) were, in a field survey on October 30 1994, established, re-established, monumented, re-monumented, recovered or restored as expressed below and in conformance with regulations and rules therefore as required in the current manual of survey instructions of the United States Department of the Interior, Bureau of Land Management or by a decree of a court of law. Furthermore, that the corner points mentioned in lines 3, 4 and 5 above were, in a field survey on _____ 19____, found, recovered, restored, established or re-established as expressed below and in conformance with the rules of the Michigan State Board of Registration for Land Surveyors or, by a Decree of a Court of law:


- A. Description of original monument and accessories and/or subsequent restoration:
- 1/4 corner common to sections 4 and 5 of T20N R15W**
 - 1839 survey by John Brink Set Wood Post #1 W.Pine 18 N32 1/2 E 11 links #2 W.Oak 8 N15W 37 links
 - 1918 survey by C.E. Mitchell Co. Sur. Set Concrete Monument #3 Pine 24 East 170 links #4 Pine 12 N63W 123 links
 - 1971 survey by Robert A. Griffin #13584 Searched for and fd. the broken Mitchell monument. Replaced it w/ a 5" sq. by 36" long conc. monument w/ brass cap. #5 P.Post 4 West 32.88 feet #6 W.Oak 4 S30E 74.08 feet #7 W.Oak 7 S35W 63.30 feet #8 W.Oak 9 N48W 60.76 feet

B. Description of corner evidence found and/or method applied in restoring or re-establishing corner:

4 found the 5" square by 36" long concrete monument w/ brass cap by Griffin buried 4" beneath the surface and in the centerline of the N-S road. Witnesses 1, 2, 4 and 7 are gone. Witness #3 is a stump. Witnesses 5, 6 and 8 are in good condition. Liber 1 Page 40 by Griffin documents the history of this corner. I could find no conflicting information that would lead to another location. This monument is accepted as the best available evidence of the position of the original corner.

C. Description of monument for corner and accessories established to perpetuate locating the position of the corner:

1/4 corner common to sections 4 and 5 of T20N R15W
Monu. The 5" square by 36" long concrete monu. with 3" brass disk was left in place.
Witnesses:
W.Pine 7 S89E 77.40 feet
P.Pole S9W 75.29 feet
P.Post 4 West 32.91 feet (#5)
W.Oak 7 S35E 74.05 feet (#6)
W.Oak 12 N48W 60.77 feet (#8)

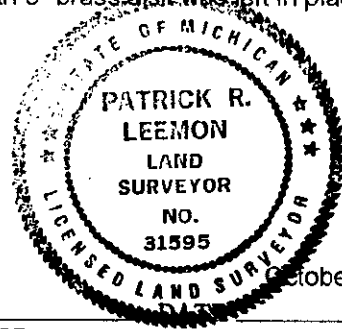

SIGNED BY Patrick R. Leemon 31595

SURVEYOR'S MICHIGAN REGISTRATION NO. _____ (SEAL)

FOR STATE AND UNITED STATES AGENCIES:

SIGNED BY _____ DATE _____
CHIEF OF SURVEY PARTY

APPROVED AND SIGNED BY _____ DATE _____
MICHIGAN REGISTERED LAND SURVEYOR (SEAL)

LIBER 3 PAGE 203

SURVEYOR'S MICHIGAN REGISTRATION NO. _____

Peer Group Reviewed and Approved
Date: 11/17/98
Kenneth L. Koss

Peer Group Reviewed and Approved
Date: 11/17/98
Kenneth L. Koss
Mason County Surveyor