

MAR 16 1998 **LAND CORNER RECORDATION CERTIFICATE**

FILING REQUIREMENT OF ACT 74, MICH. P.A.1970

SECTION _____

FOR CORNERS OF--:	LOCATED IN--:	CORNER CODE NUMBER
1. PUBLIC LAND SURVEY _____ T. _____	20N N. 15W E. S., R. _____ W.	F1
2. PROPERTY CONTROLLING IN SECTION _____ T. _____	N. _____ E. S., R. _____ W.	<i>Seg. 2</i>
3. MISCELLANEOUS PROPERTY IN SECTION _____ T. _____	N. _____ E. S., R. _____ W.	
4. LOT NO. _____, RECORDED PLAT _____		
5. PRIVATE CLAIMS _____		

FILED

AT 10:10 O'CLOCK a

NOV 17 1994

MARY GOLDEN KOLASKI
MASON COUNTY
REGISTER OF DEEDS

REGISTER OF DEEDS STAMP AND FILING NUMBER

I, Patrick R. Leemon do hereby certify that under requirements of P.A. 74, Michigan P.A. of 1970, the corner points mentioned in lines 1 and 2 above (identified with circles on index code diagram—over) were, in a field survey on October 30 1994, established, re-established, monumented, re-monumented, recovered or restored as expressed below and in conformance with regulations and rules therefore as required in the current manual of survey instructions of the United States Department of the Interior, Bureau of Land Management or by a decree of a court of law. Furthermore, that the corner points mentioned in lines 3, 4 and 5 above were, in a field survey on _____ 19____, found, recovered, restored, established or re-established as expressed below and in conformance with the rules of the Michigan State Board of Registration for Land Surveyors or, by a Decree of a Court of law:

A. Description of original monument and accessories and/or subsequent restoration:

Closing Quarter Corner on the North Line of Section 4 T20N R15W

This corner was not established by the General Land Office

1918 survey by C.E. Mitchell
Set a Conc. Monu. w/ 1" gas pipe
#1 Oak 4 S27E 12.5 links
#2 Oak 8 S15W 18 links
#3 NE Cor. Sec. 4 East 39.68 ch.
#4 NW Cor. Sec. 4 West 39.68 ch.

1971 survey by Robert A. Griffin 13584

Found the conc. monu. by Mitchell and replaced it with a 5" sq. by 60" long conc. monu. w/ brass cap.
#7 W.Oak ? S78E 106.13 feet
#8 P.Post 4 South 1.8 feet
#9 NE cor. of conc. block cabin S37W 51.77 feet

B. Description of corner evidence found and/or method applied in restoring or re-establishing corner:

I found the 5" square by 60" long concrete monument w/ brass cap by Griffin extending 12" above the surface and 410 feet North of the centerline of the E-W road and 37 feet west of a driveway. Witness 2 is a stump. Witness 1, 5, 6 and 7 are in good condition. Liber 1 Page 43 by Griffin documents the history of this corner. I could find no conflicting evidence that would lead to another location. This monument is accepted as the best available evidence of the position of the corner.


C. Description of monument for corner and accessories established to perpetuate locating the position of the corner:

Closing Quarter Corner on the North Line of Section 4 T20N R15W

Monu. The 5" square by 60" long concrete monu. with 3" brass disk was left in place.

Witnesses:

S1/4 34 T21N R15W 5x60 conc. monu. West 143.79 feet
Rebar 5/8" x 24" N2W 28.92 feet
Rebar 5/8" x 24" N58E 63.47 feet
W.Oak 11 S78E 106.20 feet (#5)
P.Post 4 South 1.8 feet (#6)

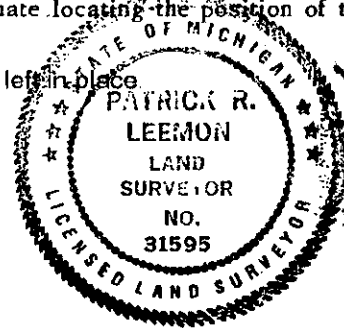

Peer Group Reviewed and Approved
Date: _____
Kenneth L. Ross
Mason County Surveyor

SIGNED BY Patrick R. Leemon 31595 DATE October 30, 1994

SURVEYOR'S MICHIGAN REGISTRATION NO. _____ (SEAL)

FOR STATE AND UNITED STATES AGENCIES:

SIGNED BY _____ CHIEF OF SURVEY PARTY DATE _____

APPROVED AND SIGNED BY _____ MICHIGAN REGISTERED LAND SURVEYOR DATE _____ (SEAL)

LIBER 3 PAGE 205

SURVEYOR'S MICHIGAN REGISTRATION NO. _____