

MAR 16 1998

LAND CORNER RECORDATION CERTIFICATE

Filing Requirement of Act 74, Mich. P.A. 1970

SECTION

For corners in MASON Located In: _____ Corner Code # _____
 (County)

1. Public Land Survey T 20N R 16W B-1
 T _____ R _____
 T _____ R _____
 T _____ R _____

2. Property Controlling S _____ T _____ R _____
 in Section S _____ T _____ R _____

3. Miscellaneous S _____ T _____ R _____
 Property in Sec. S _____ T _____ R _____

4. Lot No. _____, Recorded Plat _____

5. Private Claims _____

FILED
 AT 11:30 O'CLOCK a M
 OCT 17 1997
 MARY GOLDEN KOLASKI
 MASON COUNTY
 REGISTER OF DEEDS
 Register of Deeds Stamp & File Number

I, Kenneth L. Ross, in a field survey on September 12 19 97, do hereby certify that under requirements of P.A. 74, Michigan P.A. of 1970, the corner points mentioned in lines 1 and 2 above were in conformance with regulations and rules therefore as required in the current manual of survey instructions of the United States Department of the Interior, Bureau of Land Management or by a decree of a Court of Law and/or that the corner points mentioned in lines 3, 4 and 5 above were in conformance with the rules of the Michigan Board of Land Surveyors or by a Decree of a Court of Law; established, re-established, monumented, re-monumented, recovered, found as expressed below:

	A	B	C	D	E	F	G	H	I	J	K	L	M
1													
2	6	5	4	3	2	1							
3													
4	7	8	9	10	11	12							
5													
6	18	17	16	15	14	13							
7													
8	19	20	21	22	23	24							
9													
10	30	29	28	27	26	25							
11													
12	31	32	33	34	35	36							
13													

NOTE: Not more than 4 corners, all in the same town and range, may be recorded on this certificate.

A. Description of original monument and accessories and/or subsequent restoration:

B-1 North 1/4 Corner for Section 6, T20N, R16W, on the township line.

Note: GLO did not survey this corner.

1982, Robert A. Griffin, RLS 13584 Set 5" square x 60' Conc. Monument Griffin established this corner by single proportional measurement and on a straight line between controlling corners.

- #1 Black Oak 12" S 03° E 69.54'
- #2 White Oak 16" S 33° E 103.38'
- #3 Iron Pipe 1 1/2" x 60" west 1.6'

Griffin gives a distance of 1579.61 feet to the SE cor. of Sec. 32 T21N-R16W. This distance has been verified. also gives a distance of 1079.11 to the South 1/4 cor. of Sec. 32 T21N-R16W. Liber 2 pg. 98


1990 Ken Ross, RLS 17634 Found 5" squ. conc. monu. by Griffin Measured 1579.63 feet to the SE cor. of Sec. 32, T21N-R16W.

B. Description of corner evidence found and/or method applied in restoring or reestablishing corner:

B-1 North 1/4 Corner for Section 6, T20N, R16W, on the township line.

On September 12, 1997, I Ken Ross and Kevin Pritchard (survey tech.) found 5" square concrete monument with 3" brass cap to identify the corner, found monument 12 feet south of center-line of two-track trail. I found no evidence to disputed this location for the North 1/4 corner.

Condition of recorded witnesses are: #1 Found in good condition #2 Found in good condition #3 Gone

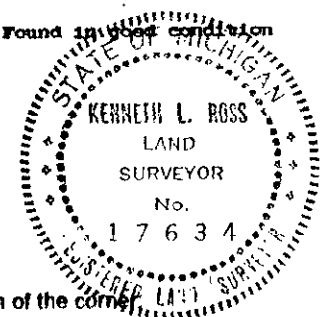

C. Description of monument for corner and accessories established to perpetuate locating the position of the corner:

B-1 North 1/4 Corner for Section 6, T20N, R16W, on the township line.

I accepted Griffin's 5" square x 36" long concrete monument with 3" brass cap as a substantial marker for the corner and is accepted as a careful and faithful establishment of the 1/4 corner.

- (ext BT #1) Black Oak 14" S 03° E 69.54' (10" dock spike in East side of tree)
- (ext BT #2) White Oak 27" S 33° E 103.38' (10" dock spike in SW side of tree)
- (new BT) Black Oak 20" N 41° E 30.55' (60d spike in SE side of tree)
- (new BT) Black Oak 18" N 14° W 61.60' (60d spike in SW side of tree)

MAR 09 1998

Signed by [Signature]

Date Oct. 4, 1997

Surveyor's Michigan License No. 17634

FORM APPROVED BY MICHIGAN STATE BOARD OF LAND SURVEYORS, JAN 28, 1971
 REVISED MAY 14, 1975
 REVISED JAN, 1983
 ADAPTED FOR WORD PROCESSING MARCH, 1993

Peer Group Reviewed and Approved
 Date: Oct 2, 1997
[Signature]
 Kenneth L. Ross
 Mason County Surveyor

LIBER 4 PAGE 107