

MAR 16 1998

SECTION

LAND CORNER RECORDATION CERTIFICATE

Filing Requirement of Act 74, Mich. P.A. 1970


For corners in
MASON
 (County)

Located In: Corner Code #

1. Public Land Survey T 20N R 16W C-2
 T R
 T R
 T R

2. Property Controlling S T R
 In Section S T R

3. Miscellaneous S T R
 Property in Sec. S T R

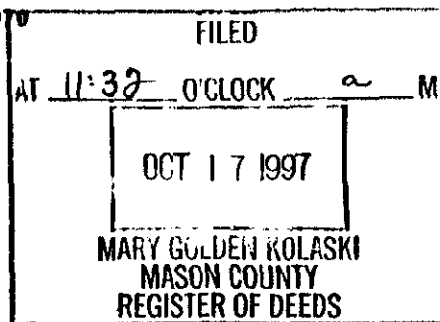

4. Lot No. _____, Recorded Plat _____
 5. Private Claims _____

I, Kenneth L. Ross, in a field survey on September, 12, 1997, do hereby certify that under requirements of P.A. 74, Michigan P.A. of 1970, the corner points mentioned in lines 1 and 2 above were in conformance with regulations and rules therefore as required in the current manual of survey instructions of the United States Department of the Interior, Bureau of Land Management or by a decree of a Court of Law and/or that the corner points mentioned in lines 3, 4 and 5 above were in conformance with the rules of the Michigan Board of Land Surveyors or by a Decree of a Court of Law; established, re-established, monumented, re-monumented, recovered, found as expressed below:

NOTE: Not more than 4 corners, all in the same town and range, may be recorded on this certificate.

	A	B	C	D	E	F	G	H	I	J	K	L	M
1													
2	6	5			4		3		2		1		
3													
4	7	8			9		10		11		12		
5													
6	18	17			16		15		14		13		
7													
8	19	20			21		22		23		24		
9													
10	30	29			28		27		26		25		
11													
12	31	32			33		34		35		36		
13													

A. Description of original monument and accessories and/or subsequent restoration:

C-2 1/4 Corner for Sections 5 and 6, T20N,R16W.


1839, John Brink, GLO Set Wood Post	1993, Gourdia/Fraser, Surveyors Found 1/2" re-rod in monument box at C-L road
#1 Maple 6" S 41° E 91ks. (5.94')	#3 Oak 36" N 63° E 53.73'
#2 Hemlock 10" S 51° W 761ks. (50.16')	#4 White Pine 8" S 85° W 47.04'
	#5 Power Pole S 20° W 96.35'
	#6 Power service Pole S 17° E 111.78'
	Drawing # 930141

B. Description of corner evidence found and/or method applied in restoring or reestablishing corner:

C-2 1/4 Corner for Sections 5 and 6, T20N,R16W.

On September 12, 1997, I Ken Ross and Kevin Pritchard (survey tech.) found 1/2" re-rod, 18" long inside a Road monument box, in the center-line of Darr Road. Also found a 3/4" Iron Pipe with 1 1/4" x 1.0, attached to the 3/4" Pipe, Due East at 33.00 feet. I found no evidence to dispute this location for the corner.

Condition of recorded witnesses are: #1 Gone #2 Gone #3 Found in good condition
 #4 Found in good condition #5 Found in good condition #6 Found in good condition

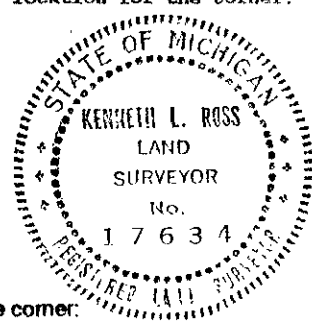

C. Description of monument for corner and accessories established to perpetuate locating the position of the corner:

C-2 1/4 Corner for Sections 5 and 6, T20N,R16W.

I replaced 1/2" re-rod inside the road monument box, with a 5/8" re-rod, 24" long, with a MASON COUNTY MONUMENT 2 1/2" aluminum cap, stamped to identify this corner and is accepted as a careful and faithful re-establishment of the position of the original corner.

(ext. BT #3) White Oak 38" N 63° W 53.73' (set 60d spike on NE side of tree)	
(ext. BT #4) White Pine 10" S 85° W 47.07' (set 60d spike on NW side of tree)	
(ext. BP #5) Power Pole S 20° W 96.35' (16p nail in NW side of pole)	
(ext. BP #6) Power Pole - service - S 17° E 111.78' (16p nail in NW side of pole)	

Signed by Kenneth L. Ross

Date Oct. 1, 1997

Surveyor's Michigan License No. 17634

FORM APPROVED BY MICHIGAN STATE BOARD OF LAND SURVEYORS, JAN. 28, 1971
 REVISED MAY 14, 1975
 REVISED JAN. 1983
 ADAPTED FOR WORD PROCESSING MARCH, 1989

Peer Group Reviewed and Approved
 Date: Oct 2 1997
Kenneth L. Ross
 Mason County Surveyor