

SURVEY & REMONUMENTATION

MAR 16 1998

LAND CORNER RECORDATION CERTIFICATE

Filing Requirement of Act 74, Mich. P.A. 1970

SECTION

For corners in
MASON
 (County)

Located in: _____ Corner Code # _____

1. Public Land Survey T 20N R 16W C-3


2. Property Controlling in Section S T R

3. Miscellaneous S T R

Property in Sec. S T R

4. Lot No. _____ Recorded Plat _____

5. Private Claims _____

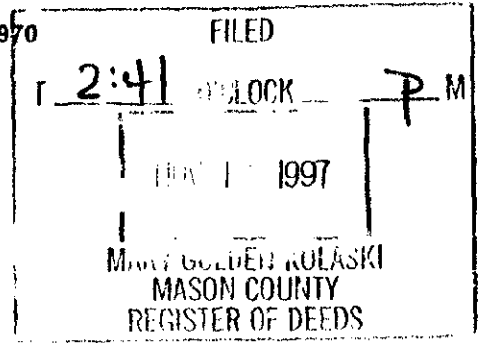

Register of Deeds Stamp & File Number

	A	B	C	D	E	F	G	H	I	J	K	L	M
1													
2	6		5		4		3		2		1		
3													
4	7		8		9		10		11		12		
5													
6	18		17		16		15		14		13		
7													
8	19		20		21		22		23		24		
9													
10	30		29		28		27		26		25		
11													
12	31		32		33		34		35		36		
13													

I, Kenneth L. Ross, in a field survey on September 12, 1997, do hereby certify that under requirements of P.A. 74, Michigan P.A. of 1970, the corner points mentioned in lines 1 and 2 above were in conformance with regulations and rules therefore as required in the current manual of survey instructions of the United States Department of the Interior, Bureau of Land Management or by a decree of a Court of Law and/or that the corner points mentioned in lines 3, 4 and 5 above were in conformance with the rules of the Michigan Board of Land Surveyors or by a Decree of a Court of Law, established, re-established, monumented, re-monumented, recovered, found as expressed below:

NOTE: Not more than 4 corners, all in the same town and range, may be recorded on this certificate.

A. Description of original monument and accessories and/or subsequent restoration:
 C-3 Section corner for Section 5, 6, 7 and 8, T20N-R16W.

- 1939, John Brink, GLO
 Set wood post
 #1 Beech 12" N 25° E 21 lks. (13.86')
 #2 Hemlock 12" N 55° W 31 lks. (20.46')
- 1966, Robert A. Griffin, RLS # 13584
 Tree Tag witness to existing to the Rail-Road spike.
 #3 Power Pole N 55° W 56.93'

- 1993, Gourdie\Fraser
 Found Rail-Road spike in monument box
 #3 Power Pole N 60° W 57.16'
 #4 White Pine 28" S 55° W 52.99'
 #5 Red Pine 10" S 60° E 61.90'
 #6 Hemlock 18" N 20° E 88.69'

B. Description of corner evidence found and/or method applied in restoring or reestablishing corner:
 C-3 Section corner for Section 5, 6, 7 and 8, T20N-R16W.

On September 12, 1997, I Ken Ross and Kevin Pritchard (survey tech.) found a Rail-Road spike inside a road monument box, at the intersection of Hoague Road and Darr Road. I found no evidence to dispute this location for the corner.

Condition of recorded witnesses are: #1 Gone #2 Gone #3 Found in good condition
 #4 Found in good condition #5 Found in good condition #6 Found in good condition

C. Description of monument for corner and accessories established to perpetuate locating the position of the corner:
 C-3 Section corner for Section 5, 6, 7 and 8, T20N-R16W.

I replaced Rail-Road spike with a 5/8" Re-rod, 24" in length with an 2 1/2" aluminum cap, stamped MASON COUNTY MONUMENT, also stamped to identify the corner. Corner set inside an existing road monument box. The corner is accepted as a careful and faithful re-establishment of the position of the original corner.

- (ext BP #3) Power Pole N 55° W 57.16' (60d spike in NE side of pole) tree tag by Griffin 1966-56.93' N 55° W
 (ext BT #4) White Pine 40" S 55° W 52.99' (60d spike in NW side of tree)
 (ext BT #5) Red Pine 18" S 60° E 61.95' (60d spike in SW side of tree)
 (ext BT #6) Hemlock 20" N 20° E 88.69' (60d spike in SE side of tree)
 (ext BP, not recorded) Power Pole S 70° W 54.48' (16p with shiner in SE side of tree)

Signed by [Signature] Date Oct 1, 1997
 Surveyor's Michigan License No. 17634

FORM APPROVED BY MICHIGAN STATE BOARD OF LAND SURVEYORS.

JAN 28, 1971

REVISED MAY 14, 1975
 REVISED JAN. 1983
 ADAPTED FOR WORD PROCESSING MARCH, 1993

LIBER 4 PAGE 131

Fee Group B...
 Date: Oct 1, 1997
 Mason County Surveyor