

SURVEY & REMONUMENTATION

MAR 16 1998

LAND CORNER RECORDATION CERTIFICATE

Filing Requirement of Act 74, Mich. P.A. 1970


For corners in SECTION
Mason (County)

Located in:

Corner Code #

- | | | |
|------------------------------------|-------------------------|-------|
| 1. Public Land Survey | T 20N R 16W | D-1 |
| | T _____ R _____ | _____ |
| | T _____ R _____ | _____ |
| | T _____ R _____ | _____ |
| 2. Property Controlling in Section | S _____ T _____ R _____ | _____ |
| | S _____ T _____ R _____ | _____ |
| 3. Miscellaneous Property in Sec. | S _____ T _____ R _____ | _____ |
| | S _____ T _____ R _____ | _____ |

4. Lot No. _____, Recorded Plat _____
5. Private Claims _____

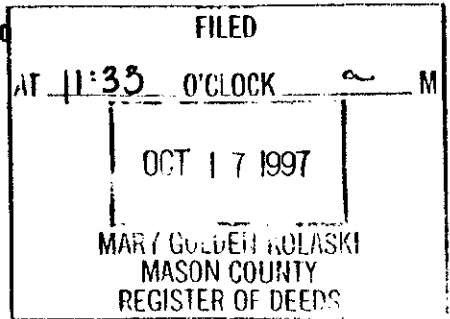

Register of Deeds Stamp & File Number

I, Kenneth L. Ross, in a field survey on September 12, 19 97, do hereby certify that under requirements of P.A. 74, Michigan P.A. of 1970, the corner points mentioned in lines 1 and 2 above were in conformance with regulations and rules therefore as required in the current manual of survey instructions of the United States Department of the Interior, Bureau of Land Management or by a decree of a Court of Law and/or that the corner points mentioned in lines 3, 4 and 5 above were in conformance with the rules of the Michigan Board of Land Surveyors or by a Decree of a Court of Law; established, re-established, monumented, re-monumented, recovered, found as expressed below.

NOTE: Not more than 4 corners, all in the same town and range, may be recorded on this certificate.

A. Description of original monument and accessories and/or subsequent restoration:
D-1 North 1/4 Corner for Section 5, T20N-16W.

Note: G.L.O. did not survey this corner.
1972, Robert A. Griffin, Set 5" sq. conc. monument, 60" long, with 3" brass cap
Established the location of this corner at a proportional distance and on a straight line between controlling corners.
Corner is 153 feet south of County line road, 1.5 feet above ground surface. Liber 1 page 178

- #1 Red Pine 7" S 50° E 76.30'
- #2 Black Oak 6" S 12° E 68.68'
- #3 White Oak 4" S 80° W 23.17'
- #4 Pine Post 4" East 1.3'

B. Description of corner evidence found and/or method applied in restoring or reestablishing corner:

D-1 North 1/4 Corner for Section 5, T20N-16W.

On September 12, 1997, I Ken Ross and Kevin Pritchard (survey tech.) found 5" square conc. monument with 3" brass cap, placed by Griffin, the brass cap is stamped to identify this corner, and is 153 south of the center-line of County line Road, and stands 1.5 feet above the ground surface. I found no evidence to dispute this location for the corner.

Condition of recorded witnesses are: #1 Found in good condition ; note identify as a white pine
#2 Found in good condition #3 Found in good condition #4 Found in good condition


C. Description of monument for corner and accessories established to perpetuate locating the position of the corner:

D-1 North 1/4 Corner for Section 5, T20N-16W.

I accepted Griffin's 5" square concrete, 36" long, with 3" brass cap as a substantial marker for the corner, and is accepted as a careful and faithful establishment of the North 1/4 corner.

- (ext. BT #1) White Pine 16" S 50° E 76.30' (10" dock spike in NE side of tree)
- (ext. BT #2) Black Oak 10" S 12° E 68.68' (10" dock spike in NE side of tree)
- (ext. BT #3) White Oak 8" S 80° W 23.17' (10" dock spike in SE side of tree)
- (new BT) White Pine 22" N 08° E 56.85' (60d spike in West side of tree)

	A	B	C	D	E	F	G	H	I	J	K	L	M
1													
2	6	5	4	3	2	1							
3													
4	7	8	9	10	11	12							
5													
6	18	17	16	15	14	13							
7													
8	19	20	21	22	23	24							
9													
10	30	29	28	27	26	25							
11													
12	31	32	33	34	35	36							
13													

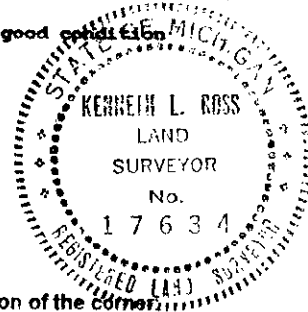

Signed by [Signature] Date Oct. 1, 1997

Surveyor's Michigan License No. 17634

FORM APPROVED BY MICHIGAN STATE BOARD OF LAND SURVEYORS, JAN. 28, 1971
REVISED MAY 14, 1976
REVISED JAN., 1983
ADAPTED FOR WORD PROCESSING MARCH, 1993

LIBER 4 PAGE 110

Peer Group Reviewed and Approved
Date: Oct. 2, 1997
[Signature]
Kenneth L. Ross
Mason County Surveyor