

SURVEY & REMONUMENTATION


MAR 16 1998

LAND CORNER RECORDATION CERTIFICATE

Filing Requirement of Act 74, Mich. P.A. 1978

For corners in **SECTION**

<u>MASON</u> (County)	Located In:	Corner Code #
1. Public Land Survey	T 20N R 16W	E-1
	T _____ R _____	_____
	T _____ R _____	_____
2. Property Controlling in Section	S _____ T _____ R _____	_____
3. Miscellaneous Property in Sec.	S _____ T _____ R _____	_____

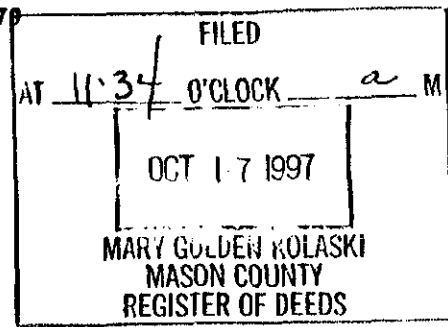

4. Lot No. _____, Recorded Plat _____
5. Private Claims _____

I, Kenneth L. Ross, in a field survey on September 12, 19 97, do hereby certify that under requirements of P.A. 74, Michigan P.A. of 1970, the corner points mentioned in lines 1 and 2 above were in conformance with regulations and rules therefore as required in the current manual of survey instructions of the United States Department of the Interior, Bureau of Land Management or by a decree of a Court of Law and/or that the corner points mentioned in lines 3, 4 and 5 above were in conformance with the rules of the Michigan Board of Land Surveyors or by a Decree of a Court of Law, established, re-established, monumented, re-monumented, recovered, found as expressed below:

A	B	C	D	E	F	G	H	I	J	K	L	M
1												
2	6	5	4	3	2	1						
3												
4	7	8	9	10	11	12						
5												
6	18	17	16	15	14	13						
7												
8	19	20	21	22	23	24						
9												
10	30	29	28	27	26	25						
11												
12	31	32	33	34	35	36						
13												

NOTE: Not more than 4 corners, all in the same town and range, may be recorded on this certificate.

A. Description of original monument and accessories and/or subsequent restoration:

E-1 Section Corner for Sections 4 and 5, T20N,R16W


- 1839, John Brink, GLO
Set Wood Post
- #1 White Pine 13" S 28° E 421ks. (27.72')
- #2 Yellow Pine 13" S 40° W 281ks. (18.48')
- #3 Red Oak 5" S 47° E 30.34'
- 1972, Robert A. Griffin, RLS #13584
Set 5" sq. x 60" conc. monument at a proportional distance and on a straight line between controlling corners.
- #4 White Oak 5" S 12° E 29.65'
- #5 Red Oak 4" S 82° W 9.67'
- #6 Pine Post 4" sq. East 1.3' Liber 1, Page 179

B. Description of corner evidence found and/or method applied in restoring or reestablishing corner:

E-1 Section Corner for Sections 4 and 5, T20N,R16W

On September 12, 1997, I Ken Ross and Kevin Pritchard (survey tech.) found Griffin's 5" concrete monument, 60" long, with a 3" brass cap, stamped to identify this corner, found monument 259 feet South of County Line Road Monument is 150 feet West of two-track road, monument stands 1.5 feet above the ground surface.

Condition of recorded witnesses are: #1 Gone #2 Gone #3 Found in good condition
#4 Found in good condition #5 Found in good condition #6 Found in good condition

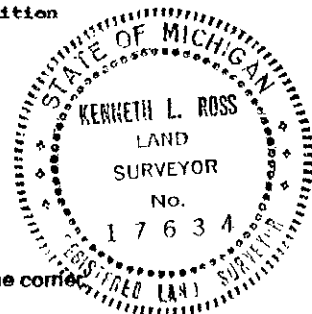

C. Description of monument for corner and accessories established to perpetuate locating the position of the corner:

E-1 Section Corner for Sections 4 and 5, T20N,R16W

I accepted Griffin's 5" square concrete monument, 60" long, with 3" brass cap, as a substantial marker for this corner and is accepted as a careful and faithful re-establishment of the position of the original corner.

- (ext. BT #3) Red Oak 7" S 47° E 30.34' (10" dock spike in SW side of tree)
- (ext. BT #4) White Oak 7" S 12° E 29.65' (10" dock spike in SW side of tree)
- (ext. BT #5) Red Oak 6" S 82° W 9.67' (10" dock spike in North side tree)
- (new BT) Black Oak 8" N 23° W 36.29' (60d spike in NE side of tree)

Signed by Kenneth L. Ross Date Oct. 1, 1997

Surveyor's Michigan License No. 17634

FORM APPROVED BY MICHIGAN STATE BOARD OF LAND SURVEYORS, JAN 28, 1971
REVISED MAY 14, 1975
REVISED JAN. 1983
ADAPTED FOR WORD PROCESSING MARCH 1995

LIBER 4 PAGE 111
Peer Group Reviewed and Approved
Date: Oct 16 1997
Kenneth L. Ross
Mason County Surveyor