

SURVEY & REMONUMENTATION

SEP 30 1993

COMMISSION


LAND CORNER RECORDATION CERTIFICATE Filing Requirement of Act 74, Mich. P.A. 1970

For corners in
MASON _____
(County)

Located In:

Corner Code #

- | | | |
|------------------------------------|-------------------------|----------|
| 1. Public Land Survey | T 20 N R 16 W | E-5, E-6 |
| | T _____ R _____ | _____ |
| | T _____ R _____ | _____ |
| | T _____ R _____ | _____ |
| 2. Property Controlling in Section | S _____ T _____ R _____ | _____ |
| | S _____ T _____ R _____ | _____ |
| 3. Miscellaneous Property in Sec. | S _____ T _____ R _____ | _____ |
| | S _____ T _____ R _____ | _____ |

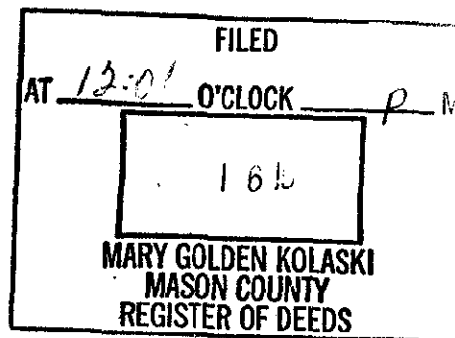

Register of Deeds Stamp & File Number

4. Lot No. _____, Recorded Plat _____
5. Private Claims _____

I, Sammy S. Barnett, in a field survey on _____ August _____, 1993, do hereby certify that under requirements of P.A. 74, Michigan P.A. of 1970, the corner points mentioned in lines 1 and 2 above were in conformance with regulations and rules therefore as required in the current manual of survey instructions of the United States Department of the Interior, Bureau of Land Management or by a decree of a Court of Law and/or that the corner points mentioned in lines 3, 4 and 5 above were in conformance with the rules of the Michigan Board of Land Surveyors or by a Decree of a Court of Law; established, re-established, monumented, re-monumented, recovered, found as expressed below:

	A	B	C	D	E	F	G	H	I	J	K	L	M
2	6	5	4	3	2	1							
3													
4	7	8	9	10	11	12							
5													
6	18	17	16	15	14	13							
7													
8	19	20	21	22	23	24							
9													
10	30	29	28	27	26	25							
11													
12	31	32	33	34	35	36							
13													

NOTE: Not more than 4 corners, all in the same town and range, may be recorded on this certificate.

A. Description of original monument and accessories and/or subsequent restoration:

E-5 Section corner, Sec's., 8, 9, 16 & 17

Post placed by John Brink in 1839 subdivision survey.
S 85° E 16 lks. (10.56') 10" Beech
S 71° W 26 lks. (17.16') 10" Beech



1/4 corner, Sec's., 16 & 17

Post placed by John Brink in 1839 subdivision survey.
S 66 1/2° E 23 lks. (15.18') 10" Cedar
N 76° W 20 lks. (13.20') 10" Cedar

Robert Griffin placed 1/2" Rebar in 1975.
N 32° E 75.97' 6" Red Pine
S 26° E 44.29' 13" Tw. White Oak

R. O. Towns found original Gov't. witness in April 1898 subdivision survey.

B. Description of corner evidence found and/or method applied in restoring or reestablishing corner:

E-5 Section corner, Sec's., 8, 9, 16 & 17

Ken Ross found 1/2" Iron in August, 1977 survey
S 25° E 44.29' 12" Oak
N 30° E 61.31' 6" Red Pine
N 35° W 81.31' 18" Oak

Norm Caldwell found 1/2" Rebar, and replaced with 2 1/2" X 30" stainless steel pipe w/ brass cap, in July, 1991 subdivision survey.
N 37° E 61.23' 10" Red Pine
S 58° W 43.58' 10" White Tw. Oak
S 50° E 48.15' 3" Red Oak
N 35° W 81.29' 24" White Oak

E-6 1/4 corner, Sec's., 16 & 17

Norm Caldwell found 1 1/2" X 30" Pipe and old wood post, w/ old fence to the East.
Replaced pipe with 2 1/2" X 30" stainless steel pipe w/ brass cap.
S 62° W 53.35' 10" Black Oak
S 85° W 38.07' 10" Sugar Maple
S 67° E 45.26' 10" Beech
S 27° E 78.52' 10" Yellow Birch

C. Description of monument for corner and accessories established to perpetuate locating the position of the corner:

E-5 Section corner, Sec's., 8, 9, 16 & 17

Found 2 1/2" X 30" stainless steel pipe w/ brass cap, accepted as a substantial marker for corner, and also recovered Caldwell's witnesses and is accepted as the best available evidence of the position of the original corner.
N 37° E 61.23' 10" Red Pine
S 58° W 43.58' 10" Tw. White Oak
S 50° E 48.15' 3" Red Pine
N 35° W 81.29' 24" White Oak

E-6 1/4 corner, Sec., 16 & 17

Found 2 1/2" X 30" stainless steel pipe w/ brass cap, accepted as a substantial marker for corner and also recovered Caldwell's witnesses, and is accepted as the best available evidence of the position of the original corner.
S 62° W 53.35' 10" Black Oak
S 85° W 38.07' 10" Sugar Maple
S 67° E 45.26' 10" Beech
S 27° E 78.52' 10" Yellow Birch

Signed by Sammy S. Barnett

Date 9/9/93

Surveyor's Michigan License No. 16923

Peer Group Reviewed and Approved
Date: 9-9-93
Kenneth L. Ross
Masca County Surveyor

FORM APPROVED BY MICHIGAN STATE BOARD OF LAND SURVEYORS, JAN. 28, 197
REVISED MAY 14, 197
REVISED JAN., 198