

**SURVEY &
REMONUMENTATION**

MAR 16 1998

LAND CORNER RECORDATION CERTIFICATE

Filing Requirement of Act 74, Mich. P.A. 1970

SECTION
For corners in
Mason
(County)

Located In:

Corner Code #

1. Public Land Survey T 20N R 16W E-13
T _____ R _____
T _____ R _____
T _____ R _____
2. Property Controlling S _____ T _____ R _____
in Section S _____ T _____ R _____
3. Miscellaneous S _____ T _____ R _____
Property in Sec. S _____ T _____ R _____

4. Lot No. _____, Recorded Plat _____
5. Private Claims _____

I, Richard L. Hays, in a field survey on August 1997, do hereby certify that under requirements of P.A. 74, Michigan P.A. of 1970, the corner points mentioned in lines 1 and 2 above were in conformance with regulations and rules therefore as required in the current manual of survey instructions of the United States Department of the Interior, Bureau of Land Management or by a decree of a Court of Law and/or that the corner points mentioned in lines 3, 4 and 5 above were in conformance with the rules of the Michigan Board of Land Surveyors or by a Decree of a Court of Law; established, re-established, monumented, re-monumented, recovered, found as expressed below:

NOTE: Not more than 4 corners, all in the same town and range, may be recorded on this certificate.

A. Description of original monument and accessories and/or subsequent restoration:

E-13 SOUTHEAST CORNER OF SECTION 32, T20N-R16W

1839: G.L.O Survey

- 18" Birch N-55°-E 24 lks (1)
10" Hemlock N-53°-W 10 lks (2)

1881: Ross Survey #17634

Act 132, Liber 277, Page 457

Found 5/8" Iron Rod

- 8" Pine Northwest 71.97' (3)
Fence Post Northeast 43.27' (4)
Power Pole Southeast 55.97' (5)

1/2" Iron Rod East 18.50' (6) Closing Corner

B. Description of corner evidence found and/or method applied in restoring or reestablishing corner:

E-13 SOUTHEAST CORNER OF SECTION 32, T20N-R16W

August 1997: Found 5/8" Iron Rod. Condition of the Witnesses are as follows:


- 18" Birch N-55°-E 24 lks (1) (GONE)
10" Hemlock N-53°-W 10 lks (2) (GONE)
8" Pine Northwest 71.97' (3) (FOUND)
Fence Post Northeast 43.27' (4) (GONE)
Power Pole Southeast 55.97' (5) (FOUND)
1/2" Iron Rod East 18.50' (6) (FOUND)

C. Description of monument for corner and accessories established to perpetuate locating the position of the corner:

E-13 SOUTHEAST CORNER OF SECTION 32, T20N-R16W

August 1997: Replace the 5/8" Iron Rod with a Standard Mason County Monument, as a careful and faithful re-establishment of the position of the Original Corner.

- Spike NE side 15" Red Pine N-52°-W 71.45' (3)
Spike SW side Power Pole S-50°-E 56.20' (5)
Spike SE side 3" Red Pine S-50°-W 60.67'
"x" on Phone Box N-40°-E 41.02'
1/2" Iron East 18.50' (6) Closing Corner

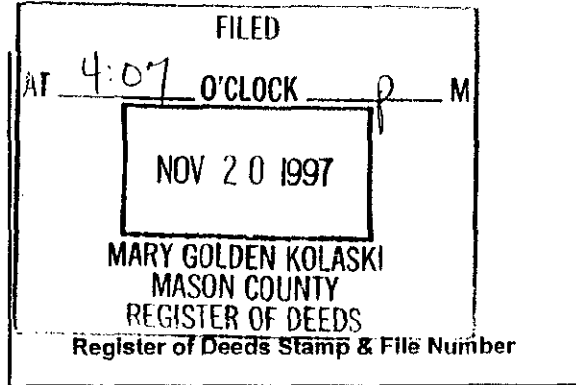

	A	B	C	D	E	F	G	H	I	J	K	L	M
1													
2	6	5	4	3	2	1							
3													
4	7	8	9	10	11	12							
5													
6	18	17	16	15	14	13							
7													
8	19	20	21	22	23	24							
9													
10	30	29	28	27	26	25							
11													
12	31	32	33	34	35	36							
13													

Signed by Richard Hays Date 11/6/97

Surveyor's Michigan License No. 25847

FORM APPROVED BY MICHIGAN STATE BOARD OF LAND SURVEYORS, JAN. 28, 1974

Peer Group Reviewed and Approved

Date Nov. 2, 1997

[Signature]
Mason County Surveyor

REVISED MAY 14, 1975
REVISED JAN., 1983

ADAPTED FOR WORD PROCESSING MARCH, 1993