

**SURVEY & REMONUMENTATION**

MAR 16 1998

**LAND CORNER RECORDATION CERTIFICATE**

Filing Requirement of Act 74, Mich. P.A. 1970

**SECTION**


For corners in

Mason  
(County)

Located In:

Corner Code #

- 1. Public Land Survey      T 20N R 16W      F-13
- T \_\_\_\_\_ R \_\_\_\_\_
- T \_\_\_\_\_ R \_\_\_\_\_
- T \_\_\_\_\_ R \_\_\_\_\_
- 2. Property Controlling    S \_\_\_\_\_ T \_\_\_\_\_ R \_\_\_\_\_
- in Section                S \_\_\_\_\_ T \_\_\_\_\_ R \_\_\_\_\_
- 3. Miscellaneous S        T \_\_\_\_\_ R \_\_\_\_\_
- Property in Sec.        S \_\_\_\_\_ T \_\_\_\_\_ R \_\_\_\_\_
- 4. Lot No. \_\_\_\_\_, Recorded Plat \_\_\_\_\_
- 5. Private Claims \_\_\_\_\_

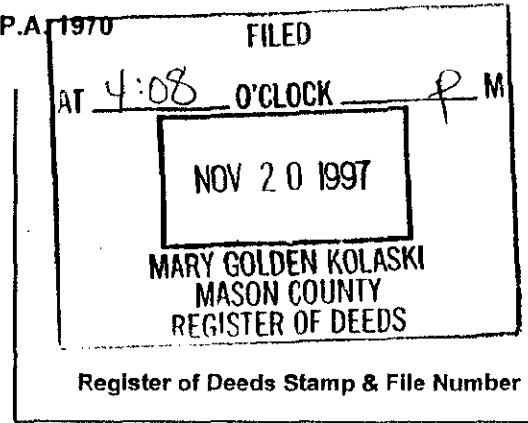

	A	B	C	D	E	F	G	H	I	J	K	L	M
1													
2	6	5	4	3	2	1							
3													
4	7	8	9	10	11	12							
5													
6	18	17	16	15	14	13							
7													
8	19	20	21	22	23	24							
9													
10	30	29	28	27	26	25							
11													
12	31	32	33	34	35	36							
13													

I, Richard L. Hays, in a field survey on August 1997, do hereby certify that under requirements of P.A. 74, Michigan P.A. of 1970, the corner points mentioned in lines 1 and 2 above were in conformance with regulations and rules therefore as required in the current manual of survey instructions of the United States Department of the Interior, Bureau of Land Management or by a decree of a Court of Law and/or that the corner points mentioned in lines 3, 4 and 5 above were in conformance with the rules of the Michigan Board of Land Surveyors or by a Decree of a Court of Law; established, re-established, monumented, re-monumented, recovered, found as expressed below:

**NOTE. Not more than 4 corners, all in the same town and range, may be recorded on this certificate.**

**A. Description of original monument and accessories and/or subsequent restoration:**

F-13 SOUTH QUARTER CORNER OF SECTION 33, T20N-R16W  
 1839: G.L.O Survey  
 12" B. Ash N-63°-E 33 lks (1)  
 12" B. Ash N-45°-W 28 lks (2)

**B. Description of corner evidence found and/or method applied in restoring or reestablishing corner:**

F-13 SOUTH QUARTER CORNER OF SECTION 33, T20N-R16W  
 August 1997: Found no evidence of Corner. Corner was re-established by the proportionate measurement and on line between Controlling Corners.  
 Condition of the Witnesses are as follows:  
 12" B. Ash N-63°-E 33 lks (1) (GONE)  
 12" B. Ash N-45°-W 28 lks (2) (GONE)

**C. Description of monument for corner and accessories established to perpetuate locating the position of the corner:**

F-13 SOUTH QUARTER CORNER OF SECTION 33, T20N-R16W  
 August 1997: Set a Standard Mason County Monument, stamped to identify the Corner. This position is accepted as a careful and faithful re-establishment of the position of the Original Corner.  
 3/8" Re-Rod N-37°-E 35.10'  
 3/8" Re-Rod S-42°-E 43.99'  
 3/8" Re-Rod S-37°-W 14.07'  
 3/8" Re-Rod N-15°-W 16.06'  
 Closing Corner East 16.12'  
 Southwest Corner East 2638.71'  
 Southeast Corner East 2638.71'



Signed by Richard Hays

Date 11/6/97

Surveyor's Michigan License No. 25847

Peer Group Reviewed and Approved Form Approved by Michigan State Board of Land Surveyors, Jan. 28, 1971

Date: Nov 2, 1997

REVISED MAY 14, 1975  
 REVISED JAN. 1987

ADAPTED FOR WORD PROCESSING MARCH, 1993