

**SURVEY &  
REMONUMENTATION**

MAY 07 1997

**COMMISSION**

**LAND CORNER RECORDATION CERTIFICATE**

Filing Requirement of Act 74, Mich. P.A. 1970

For corners in  
Mason County  
(County)

Located In:

Corner Code #

FILED	
AT 4:01	O'CLOCK P M
OCT 11 1996	
MARY GOLDEN KOLASKI MASON COUNTY REGISTER OF DEEDS	
Register of Deeds Stamp & File Number	

1. Public Land Survey	T 20N R 16W	G-7
	T R	
	T R	
	T R	
2. Property Controlling in Section	S T R	
	S T R	
3. Miscellaneous Property in Sec.	S T R	
	S T R	

4. Lot No. \_\_\_\_\_, Recorded Plat \_\_\_\_\_  
5. Private Claims \_\_\_\_\_

I, Kenneth L. Ross in a field survey on August 1996, do hereby certify that under requirements of P.A. 74, Michigan P.A. of 1970, the corner points mentioned in lines 1 and 2 above were in conformance with regulations and rules therefore as required in the current manual of survey instructions of the United States Department of the Interior, Bureau of Land Management or by a decree of a Court of Law and/or that the corner points mentioned in lines 3, 4 and 5 above were in conformance with the rules of the Michigan Board of Land Surveyors or by a Decree of a Court of Law; established, re-established, monumented, re-monumented, recovered, found as expressed below:

	A	B	C	D	E	F	G	H	I	J	K	L	I
1													
2	6	6	4	8	2	1							
3													
4	7	8	9	10	11	12							
5													
6	18	17	16	15	14	13							
7													
8	19	20	21	22	23	24							
9													
10	30	29	28	27	26	25							
11													
12	31	32	33	34	35	36							
13													

**NOTE:** Not more than 4 corners, all in the same town and range, may be recorded on this certificate.

**A. Description of original monument and accessories and/or subsequent restoration:**

In 1839, John Brink, surveyed the original section, stating "Set Section Post common to Sections 15, 16, 21 and 22". Witnesses Given: (1) 10" Beech, N 18.5°E, 19 links, (2) 12" Beech, S31°W, 41 links. In May, 1881, C.E. Mitchell Found at this location, stated "identified by Government Marks and Witness Marks remain, (referring to GLO)". In 1979 Kenneth L. Ross, RLS, found a 1/2" pipe disturbed and replaced with 3/4" iron, while completing a survey of Section 15, T.20N., R.16W., Witnesses Given: (3) Guy Pole, S50°E, 40.90', (4) P.P. N50°E, 41.85', (5) Tel. Pole, N40°W, 72.18' Center Railroad Tracks, West 66.00'. In 1981 Kenneth L. Ross, used this corner for a survey in Section 21, T.20N., R.16W., and Section 16, T.20N., R.16W., In July, 1991, Horn C. Cadwell, RLS, replaced this corner with a 2 1/2" X 30" Stainless Steel Pipe with Brass Cap and filed an LCRC, Liber 3, page 88, Mason County Records. Witnesses Given: (3) and (4) above, additional witnesses given, (7) NE Corner Railroad Crossing sign, N60°W, 58.73', (8) P.K. in Railroad Tie, S65°W, 62.92', (9) Carsonite Witness Post, South, 33.00'. Mason County Road Commission Records, No date state iron, Witnesses Given: (10) R.R. Cross Bar, NW, 59.4', (11) P.P. NE, 41.4', (12) Broken Post, SE, 40.8', (13) Tel. Pole, SE, 69',


**B. Description of corner evidence found and/or method applied in restoring or reestablishing corner:**

In August, 1996, I found the 2 1/2" stainless steel pipe as stated above by Cadwell. Witnesses (1), (2), (5), (10), (11), (12), and (13) have been destroyed or replaced. Left the existing stainless steel pipe in place, 1.0 foot below the gravel surface.

**C. Description of monument for corner and accessories established to perpetuate locating the position of the corner:**

I accepted the 2 1/2" X 30" stainless steel pipe, 1 foot below the gravel surface as a careful and faithful re-establishment of the position of the original corner. Witnesses checked or taken:

- (3) Spike in Guy Pole, S 50° E, 40.90'
- (4) Spike in P.P. N 50°E, 41.85'
- (6) Center of Railroad Tracks, West, 66.00'
- (7) NE Corner Railroad Crossing Sign, N60°W, 58.73'
- (8) P.K. Nail in Railroad Tie, S65°W, 62.92'
- (9) Carsonite Witness Post, South, 33.00'

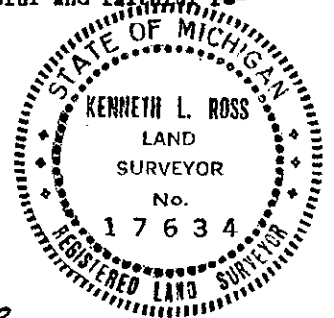

Signed by Kenneth L. Ross

Date 9-30-96

Surveyor's Michigan License No. 17634

Peer Group Reviewed and Approved

Date: 9-30-96  
Kenneth L. Ross  
Mason County Surveyor

FORM APPROVED BY MICHIGAN STATE BOARD OF LAND SURVEYORS, JAN. 28, 1971  
REVISED MAY 14, 1975  
REVISED JAN., 1983  
ADAPTED FOR WORD PROCESSING MARCH, 1993

LIBER

4 PAGE

74