

SURVEY & REMONUMENTATION


MAY 07 1997

COMMISSION

LAND CORNER RECORDATION CERTIFICATE

Filing Requirement of Act 74, Mich. P.A. 1970

For corners in	Located In:	Corner Code #
Mason County (County)		
1. Public Land Survey	T 20N R 16W	G-8
	T R	
	T R	
	T R	
2. Property Controlling in Section	S T R	
	S T R	
3. Miscellaneous Property in Sec.	S T R	
	S T R	

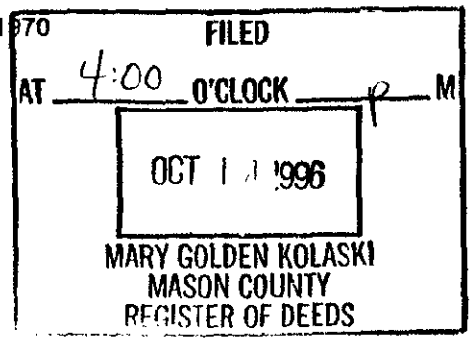

4. Lot No. _____, Recorded Plat _____
 5. Private Claims _____

I, Kenneth L. Ross, in a field survey on AUGUST, 1996, do hereby certify that under requirements of P.A. 74, Michigan P.A. of 1970, the corner points mentioned in lines 1 and 2 above were in conformance with regulations and rules therefore as required in the current manual of survey instructions of the United States Department of the Interior, Bureau of Land Management or by a decree of a Court of Law and/or that the corner points mentioned in lines 3, 4 and 5 above were in conformance with the rules of the Michigan Board of Land Surveyors or by a Decree of a Court of Law; established, re-established, monumented, re-monumented, recovered, found as expressed below:


	A	B	C	D	E	F	G	H	I	J	K	L
1												
2	6	5	4	3	2	1						
3												
4	7	8	9	10	11	12						
5												
6	18	17	16	15	14	13						
7												
8	19	20	21	22	23	24						
9												
10	30	29	28	27	26	25						
11												
12	31	32	33	34	35	36						
13												

NOTE: Not more than 4 corners, all in the same town and range, may be recorded on this certificate.

A. Description of original monument and accessories and/or subsequent restoration:
 Ink 1839, John Brink, laid out the original corners, Stating "Set 4 Corner common to Sections 21 and 22". Witnesses Given: (1) 12" Beech, N21°E, 19 links, (2) 10" Beech, S88°W, 35 links. In May, 1881, C.E. Mitchell, Found Corner identified by Government Marks and Witness Marks remain in, No Witnesses Given. In 1975, Joe Borsfay, Mason County Road Commission stated "Found 1" iron, Witnesses Given: (3) 30" Basswood, S87°W, 51.9', (4) 15" Pine, N20°W, 79.69'. In 1985, Kenneth L. Ross, RLS, found iron in Monument Box, No Witnesses Given. In 1989, Kenneth L. Ross, found iron in Monument Box, No Witnesses Given. Kenneth L. Ross also used this corner completing a survey of Section 21, T.20N., R.16W., This Corner was also tied to recorded subdivisions in Liber 1, page 25 and Liber 1, page 28, Mason County Records. This Corner fits the Recorded Plat of the Village of Freesoil well.

B. Description of corner evidence found and/or method applied in restoring or reestablishing corner:
 In August, 1996, I found a 1" square bolt in Monument Box, 2.8' East of the center-line of roadway. I cross pinned the existing iron. I completed a further search and found nothing to dispute the location of this corner. Witnesses (1) through (4) have been destroyed.

C. Description of monument for corner and accessories established to perpetuate locating the position of the corner:
 I replaced the 1" square bolt, in the exact location with a Standard Mason County Monument, placed inside the Monument Box, and accepted as a careful and faithful reestablishment of the position of the original corner. Witnesses Taken:
 Spike in 42" Ash, S89°W, 31.87'
 Spike in 24" White Pine, N21°W, 79.62'
 Spike in 10" Ash, S26°W, 82.89'
 SE Corner of House, N22°W, 205.67'
 Spike in 6" Maple, S16°E, 105.00'

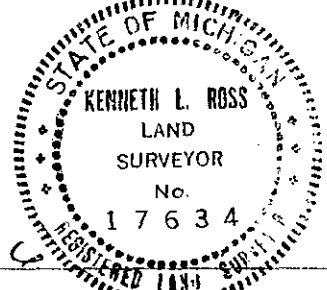

Signed by Kenneth L. Ross Date 9-30-96
 Surveyor's Michigan License No. 17634

Peer Group Reviewed and Approved
 Date: 9-30-96
Kenneth L. Ross
 Mason County Surveyor

FORM APPROVED BY MICHIGAN STATE BOARD OF LAND SURVEYORS, JAN. 28, 1971
 REVISED MAY 14, 1975
 REVISED JAN. 1983
 ADAPTED FOR WORD PROCESSING MARCH, 1993