

MAR 16 1998


LAND CORNER RECORDATION CERTIFICATE

Filing Requirement of Act 74, Mich. P.A. 1970

SECTION

For corners in

MASON (County)	Located In:	Corner Code #
1 Public Land Survey	T 20N R 16W	G-13
	T R	
	T R	
	T R	
2. Property Controlling in Section	S T R	
	S T R	
3. Miscellaneous Property in Sec.	S T R	
	S T R	

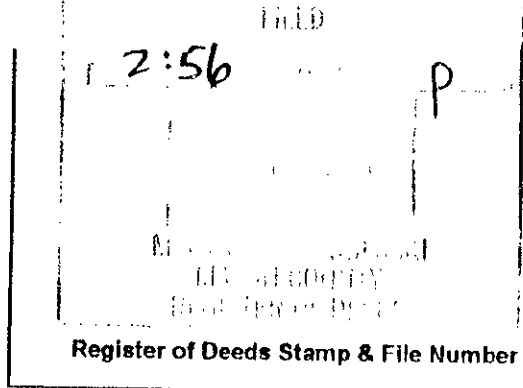

4. Lot No. _____, Recorded Plat _____
5. Private Claims _____

I, Kenneth L. Ross, in a field survey on October 27, 1997, do hereby certify that under requirements of P.A. 74, Michigan P.A. of 1970, the corner points mentioned in lines 1 and 2 above were in conformance with regulations and rules therefore as required in the current manual of survey instructions of the United States Department of the Interior, Bureau of Land Management or by a decree of a Court of Law and/or that the corner points mentioned in lines 3, 4 and 5 above were in conformance with the rules of the Michigan Board of Land Surveyors or by a Decree of a Court of Law; established, re-established, monumented, re-monumented, recovered, found as expressed below:

	A	B	C	D	E	F	G	H	I	J	K	L	M
1													
2	6	5	4	3	2	1							
3													
4	7	8	9	10	11	12							
5													
6	18	17	16	15	14	13							
7													
8	19	20	21	22	23	24							
9													
10	30	29	28	27	26	25							
11													
12	31	32	33	34	35	36							
13													

NOTE: Not more than 4 corners, all in the same town and range, may be recorded on this certificate.

A. Description of original monument and accessories and/or subsequent restoration:

G-13 Section Corner for Sections 33 and 34, On the Township line, T20N-R16W.

1837, Mullett and Brookfield, G.L.O. boundary survey
Set Wood Post

- #1 Birch 12" N 33° E 22 lks (14.52ft.)
- #2 Birch 9" N 33° W 29 lks. (19.14ft.)

1898, R.O. Towns, Mason County Survey
Used corner in Cadastral Survey of Section 34, T20N-R16W
Monument not given. Book 2 Page 9

B. Description of corner evidence found and/or method applied in restoring or reestablishing corner:

G-13 Section Corner for Sections 33 and 34, On the Township line, T20N-R16W.

On October 27, 1997, I Ken Ross and Kevin Pritchard (survey tech.), found a 3/4" Iron pipe inside an existing road monument box. Corner is at the intersection of Custer Road and Townline Road. I found no evidence to dispute the location of this corner.

C. Description of monument for corner and accessories established to perpetuate locating the position of the corner:

G-13 Section Corner for Sections 33 and 34, On the Township line, T20N-R16W.

I replaced 3/4" iron, in the exact location, with a standard Mason County Monument (5/8" re-rod, 24" long with a 2 1/2" aluminum cap, stamped to identify the corner. And is accepted as a careful and faithful re-establishment of the position of the original corner.

- Power Pole N 15° E 102.15 ft. (60d spike in NW side of pole)
- Stop Sign N 60° E 39.80 ft. (to center of metal pole)
- Poplar 12" N 45° W 101.65 ft. (60d spike in SW side of tree)
- Support Post - Tele Junc. Box S 20° W 83.29 ft. (60d spike in NW side of pole)

Signed by [Signature]
Surveyor's Michigan License No. 17634

Date Nov 5, 1997

[Signature]
Notary Public
Mason County, Michigan

