

**SURVEY & REMONUMENTATION**

MAY 07 1997

**LAND CORNER RECORDATION CERTIFICATE**

Filing Requirement of Act 74, Mich. P.A. 1970

**COMMISSION**  
For comers in

Mason County  
(County)

Located in:

Comer Code #

- |                                    |   |     |   |     |     |
|------------------------------------|---|-----|---|-----|-----|
| 1. Public Land Survey              | T | 20N | R | 16W | H-7 |
|                                    | T |     | R |     |     |
|                                    | T |     | R |     |     |
|                                    | T |     | R |     |     |
| 2. Property Controlling in Section | S | T   | R |     |     |
|                                    | S | T   | R |     |     |
| 3. Miscellaneous Property in Sec.  | S | T   | R |     |     |
|                                    | S | T   | R |     |     |

**FILED**

AT 3:59 O'CLOCK P M

**OCT 1 1996**

**MARY GOLDEN KOLASKI**  
**MASON COUNTY**  
**REGISTER OF DEEDS**

Register of Deeds Stamp & File Number

4. Lot No. \_\_\_\_\_, Recorded Plat \_\_\_\_\_
5. Private Claims \_\_\_\_\_

I, Kenneth L. Ross, in a field survey on **AUGUST**, 1996, do hereby certify that under requirements of P.A. 74, Michigan P.A. of 1970, the corner points mentioned in lines 1 and 2 above were in conformance with regulations and rules therefore as required in the current manual of survey instructions of the United States Department of the Interior, Bureau of Land Management or by a decree of a Court of Law and/or that the corner points mentioned in lines 3, 4 and 5 above were in conformance with the rules of the Michigan Board of Land Surveyors or by a Decree of a Court of Law; established, re-established, monumented, re-monumented, recovered, found as expressed below:

**NOTE: Not more than 4 corners, all in the same town and range, may be recorded on this certificate.**

	A	B	C	D	E	F	G	H	I	J	K	L
1												
2	6	5	4	3	2	1						
3												
4	7	8	9	10	11	12						
5												
6	18	17	16	15	14	13						
7												
8	19	20	21	22	23	24						
9												
10	30	29	28	27	26	25						
11												
12	31	32	33	34	35	36						
13												

**A. Description of original monument and accessories and/or subsequent restoration:**


In 1839, John Brink, set the original corner, stating "set quarter section post common to sections 15 and 22". Witnesses given: (1) 14" Beech, N03°W, 25 links, (2) 6" Beech, S60°W, 10 links. In May 1881, C.E. Mitchell, Found corner identified by Witness trees still standing (referring to GLO), No witnesses given. In October, 1908, R.O. Towns, completed a survey of Section 15, tying in this corner stating "located corner by iron and bricks", no witnesses given. In 1979, Kenneth L. Ross, RLS, reset a iron based by prorating the R.O. Towns Survey of 1908. Witnesses Given: (3) P.P. N75°W, 169.35', (4) P.P. S85°W, 237.84', (5) 1/2" iron, North, 33.01'. In June, 1981 Robert L. Wetherall, completed a survey in Section 22, tying in this corner. No Witnesses given. Mason County Road Commission Records, State "Found Iron and Bricks, No witnesses Given."

**B. Description of corner evidence found and/or method applied in restoring or reestablishing corner:**

In August 1996, I found the 5/8" iron and cap set by myself in 1979. Witnesses (3) and (5) are standing and in good condition. Witnesses (1), (2) and (4) have been destroyed.

**C. Description of monument for corner and accessories established to perpetuate locating the position of the corner:**

I replaced the existing 5/8" re-rod in the exact location with a Standard Mason County Monument, 1.0 feet below the gravel surface, and is accepted as a careful and faithful reestablishment of the position of the original corner. Witnesses checked or taken: (3) Spike in P.P. N75°W, 169.46' (5) 1/2" iron, North, 33.01' Spike in P.P. N88°E, 280.06' NE corner of Farm shed, S67°W, 142.77' Spike in P.P. S85°W, 238.24'

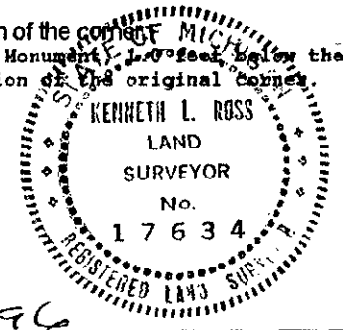

Signed by [Signature]  
Surveyor's Michigan License No. 17634

Date 9-30-96

FORM APPROVED BY MICHIGAN STATE BOARD OF LAND SURVEYORS, JAN. 28, 1971  
REVISED MAY 14, 1971  
REVISED JAN. 1971  
ADAPTED FOR WORD PROCESSING MARCH, 1971

Peer Group Reviewed and Approved  
Date: 9-30-96  
[Signature]  
Kenneth L. Ross  
Mason County Surveyor