

FEB 08 2000

SECTION

LAND CORNER RECORDATION CERTIFICATE

Filing Requirement of Act 74, Mich. P.A. 1970

For corners in MASON Located In: _____ Corner Code # _____
 (County)

1. Public Land Survey T 20N R 16W I-3
 T _____ R _____
 T _____ R _____
 T _____ R _____


2. Property Controlling S _____ T _____ R _____
 in Section S _____ T _____ R _____

3. Miscellaneous S _____ T _____ R _____

Property in Sec. S _____ T _____ R _____

4. Lot No. _____ Recorded Plat _____

5. Private Claims _____

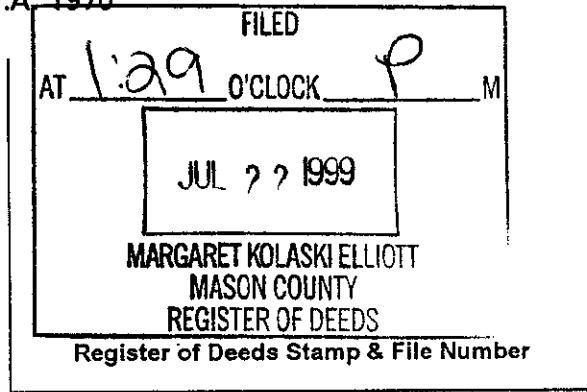

I, Kenneth L. Ross, in a field survey on May 22, 1999, do hereby certify that under requirements of P.A. 74, Michigan P.A. of 1970, the corner points mentioned in lines 1 and 2 above were in conformance with regulations and rules therefore as required in the current manual of survey instructions of the United States Department of the Interior, Bureau of Land Management or by a decree of a Court of Law and/or that the corner points mentioned in lines 3, 4 and 5 above were in conformance with the rules of the Michigan Board of Land Surveyors or by a Decree of a Court of Law; established, re-established, monumented, re-monumented, recovered, found as expressed below:

NOTE: Not more than 4 corners, all in the same town and range, may be recorded on this certificate.

A. Description of original monument and accessories and/or subsequent restoration:

- I-3, Corner Common to Sections 2, 3, 10 and 11, T.20N., R.16W., GLO John Brink, 1839 July, 1956, Dwg. K-17 K.B. Stephens, No Comment on Cor. No Witnesses Given Set post common to Secs. 2,3,10 & 11 (1) Beech, 10", N15°W, 28 links(18.48') Distance East to J-3, 2643.04' (2) White Oak, 10", S27°W, 42 links(27.72') Distance South to I-4, 2640.80'
- August, 1914, Book 2, Page 216 & 217 C.E. Mitchell, "Found Stone & Iron Bridge Truss" No Witnesses Given Distance West to H-3, 2735.04'
- December, 1971, Act 132 K.L. Ross, "Ex. 2" Pipe" (7) USFS Sign, S01° W, 26.87' (8) Elm, 12", SW, 20.00' (9) Pine, 12", SE, 52.35' (10) Pine, 12", N45°E, 19.55' Distance North to I-2, 2660.79'
- May, 1916, Book 2, Page 247 & 248 C.E. Mitchell, "Identified by Stone" (3) Pine, 10", N71°W, 37 links (4) Pine, 10", N82° 30" E, 91 links Distance East to J-3, 2659.80' Distance North to I-2, 2735.04'
- May, 1983, Act 132, Liber 303, pg 60 K.L. Ross, "1" iron in Mon Box" No Witnesses Given Distance North to I-2, 2690.68' Distance East to J-3, 2642.90'
- 1920, C.E. Mitchell (Section) 1922 DeYoung, (Replat) (same drawing), "Pump Cylinder" (5) White Oak, 18", N46°W, 30.6' (6) White Oak, 14", S72°W, 30.6'

B. Description of corner evidence found and/or method applied in restoring or reestablishing corner:

I-3, Corner Common to Sections 2, 3, 10 and 11, T.20N., R.16W., Found 1 1/4" X 24" Pipe in Monument Box. Witnesses (1) thru (10) Have been destroyed by Road Construction. On the Center-line of Hoague Road projected, Center Line of Stephens Road to South On Southerly side of Curve to the Northeast in to Rybicki Road. In the Approach Asphalt of Stephens Road. All the above witnesses Have been destroyed due to Road Construction completed in the past 6 years. I could find no other evidence to Dispute the location of this corner.

C. Description of monument for corner and accessories established to perpetuate locating the position of the corner:

- I-3, Corner Common to Sections 2, 3, 10 and 11, T.20N., R.16W., I removed the Monument Box and the 1 1/4" X 24" pipe and replace it in the exact location with a Standard 3" Cast Iron Harrison Monument and replaced the Monument Box. This corner accepted as the best available evidence of the re-establishment of the position of the original corner. (11) Maple, 24", Set 60d spike, West side, N12°W, 62.33' (12) Maple, 18", Set 60d spike, SW side, N24°W, 65.46' (13) P.P., Set 60d spike NW side, S35°W, 48.56' (14) Center Tel Box, S 66°W, 64.88' (15) Center Tel Box, N50°W, 63.71'

	A	B	C	D	E	F	G	H	I	J	K	L	M
1													
2	6	5	4	3	2	1							
3													
4	7	8	9	10	11	12							
5													
6	18	17	16	15	14	13							
7													
8	19	20	21	22	23	24							
9													
10	30	29	28	27	26	25							
11													
12	31	32	33	34	35	36							
13													

- March, 1984, Liber 2, Page 206, Dennis Dunlap "Found 2" Iron pipe" (7) USFS Sign Post, S01°W, 26.37' Witnesses (8) thru (10) given
- May, 1988, Act 132 K.L. Ross, "Monument Box" No Witnesses Given Distance South to I-4, 2641.49' Distance East to J-3, 2642.96'
- August, 1990, Act 132, K.L. Ross "1" pipe in Monument Box" Distance North to I-2, 2690.68'
- January, 1993, Act 132 K.L. Ross, "Monument Box" No Witnesses Given Distance West to H-3, 2737.04' Distance South to I-4, 2641.80'

Signed by [Signature]
 Surveyor's Michigan License No. 17634

Date July 21, 1999

Peer Group Reviewed and Approved
 Date: 7-14-99
[Signature]
 Kenneth L. Ross

