

FEB 08 2000

LAND CORNER RECORDATION CERTIFICATE

Filing Requirement of Act 74, Mich. P.A. 1970

SECTION

For corners in

MASON

(County)

Located In:

Corner Code #

- 1. Public Land Survey T 20N R 16W I-4
- 2. Property Controlling in Section S T R
- 3. Miscellaneous S T R
- Property in Sec. S T R

FILED

AT 1:30 O'CLOCK P M

JUL 22 1999

MARGARET KOLASKI ELLIOTT
MASON COUNTY
REGISTER OF DEEDS

Register of Deeds Stamp & File Number

- 4. Lot No. _____, Recorded Plat _____
- 5. Private Claims _____

I, Kenneth L. Ross, in a field survey on May 22, 1999, do hereby certify that under requirements of P.A. 74, Michigan P.A. of 1970, the corner points mentioned in lines 1 and 2 above were in conformance with regulations and rules therefore as required in the current manual of survey instructions of the United States Department of the Interior, Bureau of Land Management or by a decree of a Court of Law and/or that the corner points mentioned in lines 3, 4 and 5 above were in conformance with the rules of the Michigan Board of Land Surveyors or by a Decree of a Court of Law; established, re-established, monumented, re-monumented, recovered, found as expressed below:

NOTE: Not more than 4 corners, all in the same town and range, may be recorded on this certificate.

A. Description of original monument and accessories and/or subsequent restoration:

- | | | |
|---|-------------------------------------|---------------------------------|
| I-4, 1/4 Corner Common to Sections 10 and 11, T.20N., R.16W., | July, 1920, C.E. Mitchell (Section) | May, 1988, Act 132 |
| GLO by John Brink, 1839 | January, 1922, DeYong (Replat) | K.L. Ross, "1" pipe" |
| Set quarter Sec. Post | "Stake @ Corner" (Same drawing) | No Witnesses Given |
| (1) Hemlock, 14", S54°E, 10 links (6.6') | (5) 10" Oak, N18°E, 44.8' | Distance North to I-3, 2641.49' |
| (2) Hemlock, 18", S64°W, 13 links (8.58') | (6) 8" Oak, S61°E, 29.7' | Distance South to I-5, 2640.07' |
| 1917, Book 2, Page 520 | July, 1956, Dwg. K-17 | January, 1993, Act 132 |
| C.E. Mitchell, No Comment on Cor. | K.B. Stephens, "Ex. 3/4" pipe" | K.L. Ross, "Ex. 1" pipe" |
| (3) Pine, 10", N71° W, 37 links | Distance North to I-3, 2640.80' | No Witnesses Given |
| (4) Pine, 10", N82° 30" E, 9 links | | Distance North to I-3, 2641.80' |


	A	B	C	D	E	F	G	H	I	J	K	L	M
1													
2	6	5	4	3	2	1							
3													
4	7	8	9	10	11	12							
5													
6	18	17	16	15	14	13							
7													
8	19	20	21	22	23	24							
9													
10	30	29	28	27	26	25							
11													
12	31	32	33	34	35	36							
13													

B. Description of corner evidence found and/or method applied in restoring or reestablishing corner:

I-4, 1/4 Corner Common to Sections 10 and 11, T.20N., R.16W.,
Found 1" square X 18" Long pointed Solid Iron Bar on the center-line of Stephens Road. Witnesses (1) thru (6) are destroyed. I could find no other evidence to dispute the location of this corner.

C. Description of monument for corner and accessories established to perpetuate locating the position of the corner:

- I-4, 1/4 Corner Common to Sections 10 and 11, T.20N., R.16W.,
I replaced the 1" square X 18" long pointed bar as described above with a standard 3" Cast Iron Harrison Monument, stamped "Mason County Monument". This corner accepted as the best available evidence of the re-establishment of the Original Corner.
- (7) P.P., existing 60d spike, SE side, S15°W, 113.83'
 - (8) Maple, 24", existing 60d spike, SW Side, S27°E, 61.58'
 - (9) Ross Iron and Cap, S86°E, 33.00'
 - (10) Maple, 6", existing 60d spike, SW side, N50°W, 61.47'
 - (11) Maple, 18", existing 60d spike, South Side, N75°W, 54.61'

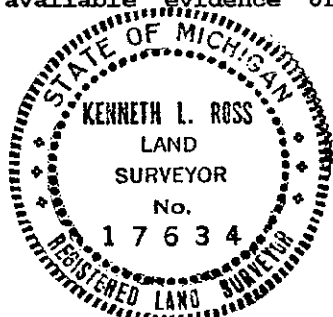

Signed by [Signature]
Surveyor's Michigan License No. 17634

Date July 21-1999

Peer Group Reviewed and Approved
Date: 7-14-99
[Signature]
Kenneth L. Ross
Mason County Surveyor