

SURVEY & REMONUMENTATION

FEB 08 2000

LAND CORNER RECORDATION CERTIFICATE

Filing Requirement of Act 74, Mich. P.A. 1970

SECTION

For corners in MASON Located In: _____ Corner Code # _____
 (County)

1. Public Land Survey T 20N R 16W I-5
 T _____ R _____
 T _____ R _____
 T _____ R _____

2. Property Controlling S _____ T _____
 in Section S _____ T _____ R _____

3. Miscellaneous S _____ T _____ R _____

Property in Sec. S _____ T _____ R _____

FILED AT 1:30 O'CLOCK P M

JUL 27 1999

MARGARET KOLASKI ELLIOTT
MASON COUNTY
REGISTER OF DEEDS

Register of Deeds Stamp & File Number

4. Lot No. _____, Recorded Plat _____
 5. Private Claims _____

I, Kenneth L. Ross, in a field survey on May 22, 1999, do hereby certify that under requirements of P.A. 74, Michigan P.A. of 1970, the corner points mentioned in lines 1 and 2 above were in conformance with regulations and rules therefore as required in the current manual of survey instructions of the United States Department of the Interior, Bureau of Land Management or by a decree of a Court of Law and/or that the corner points mentioned in lines 3, 4 and 5 above were in conformance with the rules of the Michigan Board of Land Surveyors or by a Decree of a Court of Law; established, re-established, monumented, re-monumented, recovered, found as expressed below:

NOTE: Not more than 4 corners, all in the same town and range, may be recorded on this certificate.

A. Description of original monument and accessories and/or subsequent restoration:
 I-5, Corner Common to Sections 10, 11, 14 and 15, T.20N., R.16W., GLO by John Brink July, 1956, Dwg. K-17
 1839 K. B. Stephens, "Ex. Iron Pipe"
 Set post to secs. 10, 11, 14 & 15 No Witnesses, No Distances

(1) Beech, 10", S54°E, 31 links (20.46')
 (2) Beech, 10", N16°E, 41 links (27.06')

Sept, 1908, Book 2, page 208 & 209
 R.O. Towns, "Located corner by Roads and Fences, "Planted pipe"
 Distance East to J-5, 2636.04'
 Distance South to I-6, 2650.56'

R.O. Towns, 1908, Book 2, page 210 & 211
 "Located pipe previously set"
 Distance West to H-5, 2688.84'
 Distance South to I-6, 2646.60'

July, 1920, C.E. Mitchell (Section)
 Jan, 1922, DeYoung, (Replat) Same
 Drawing "Found Gas Pipe"
 (3) White Oak, 12", S15°W, 6.6'
 (4) Oak, 7", N20°E, 30.3'
 Distance North to I-4, 2645.20'
 Distance East to J-5, 2608.00'

October, 1974, Act 132
 Liber 1, pg. 291
 Sammy Barnett, No Comment on Corner.
 (5) P.P. NW, 49.20'
 (6) Oak, 10", NE, 99.00'
 (7) White oak, 14", SE, 56.80'
 (8) White Oak, 15", SE, 52.50'
 Distance West to H-5, 2681.92'
 January, 1979, LCRC, Liber 2 pg.71

Norman L. Ochs, "Fd. Well Point"
 (9) P.P. N53°E, 49.13'
 (10) White Oak, 19", S61°E, 53.17' (8)
 (11) P.P. N43°W, 50.58' (5)??
 December, 1984, Act 132
 K.L. Ross, "Fd. 1" pipe"
 (11) P.P. N43°W, 50.70'
 (10) White Oak, 19", S60°E, 53.17' (8)
 (12) White Pine, 16", N85°E, 75.23'
 See next column

	A	B	C	D	E	F	G	H	I	J	K	L	M
1													
2	6	5	4	3	2	1							
3													
4	7	8	9	10	11	12							
5													
6	18	17	16	15	14	13							
7													
8	19	20	21	22	23	24							
9													
10	30	29	28	27	26	25							
11													
12	31	32	33	34	35	36							
13													

Distance East to J-5, 2631.31'
 Distance South to I-6, 2643.55'

May, 1988, Act 132
 K.L. Ross, "ex. Pipe"
 No Witnesses given
 Distance North to I-4, 2640.07'
 Distance East to J-5, 2631.23'

October, 1992, Act 132
 K.L. Ross, "Fd. 1 1/4" pipe"
 No Witnesses Given
 Distance South to I-6, 2643.60'

September, 1996, Act 132
 K.L. Ross, No Comment on Corner
 No Witnesses Given
 Distance West to H-5, 2681.82'

November, 1998, Act 132
 K.L. Ross, "Ex. 1" pipe"
 No Witnesses Given
 Distance South to I-6, 2643.24'

B. Description of corner evidence found and/or method applied in restoring or reestablishing corner:
 I-5, Corner Common to Sections 10, 11, 14 and 15, T.20N., R.16W.,


Found 1 1/4" X 36" Pipe in the center-line of Stephens Road, 5 foot North of the center-line Koenig Road. Gravel Road to West, Two Track to East. Witnesses (1) thru (4) and (6) thru (9) have been destroyed Witnesses (5), (10), (11) and (12) are standing and in good condition. I could find no other evidence to dispute the location of this corner.

C. Description of monument for corner and accessories established to perpetuate locating the position of the corner:
 I-5, Corner Common to Sections 10, 11, 14 and 15, T.20N., R.16W.,
 I replaced the 1 1/4" X 36" Pipe as described above with a standard 3" Cast Iron Harrison Monument, stamped "Mason County Monument". This corner accepted as the best available evidence of the re-establishment of the Original Corner.

(5) P.P. Set 60d spike, SW side, N43°W, 50.60'
 (10) White Oak, 30", Existing 60d spike, SW side, 52.85'
 (12) White Pine, 18", Existing 60d spike, South side, N85°E, 74.76'
 (13) NBT, Red Oak, 10", Set 60d spike, SE side, S61°W, 83.78'

LIBER

4 PAGE 276

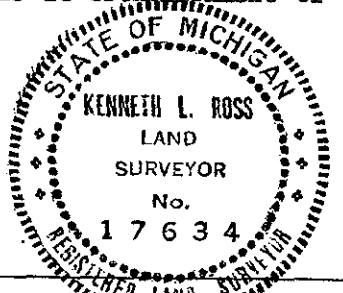

Signed by [Signature]
 Surveyor's Michigan License No. 17634

Date 7-21-99

Peer Group Reviewed and Approved
 Date: 7-14-99
[Signature]
 Kenneth L. Ross