

SURVEY & REMONUMENTATION

MAY 07 1997

COMMISSION

LAND CORNER RECORDATION CERTIFICATE

Filing Requirement of Act 74, Mich. P.A. 1970


For corners in
Mason County
 (County)

Located in: _____ Corner Code # _____

1. Public Land Survey T 20N R 16W L-7
 T _____ R _____
 T _____ R _____
 T _____ R _____

2. Property Controlling in Section S _____ T _____ R _____
 S _____ T _____ R _____

3. Miscellaneous Property in Sec. S _____ T _____ R _____
 S _____ T _____ R _____

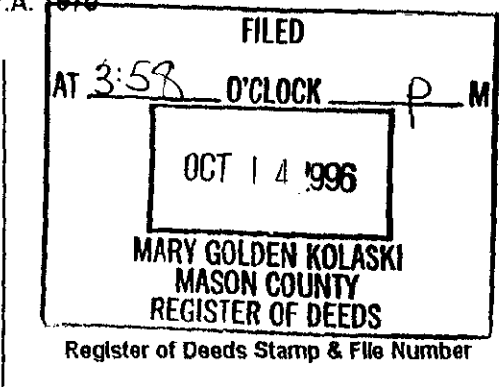

4. Lot No. _____, Recorded Plat _____
 5. Private Claims _____

	A	B	C	D	E	F	G	H	I	J	K	L	M
1													
2	6	5	4	3	2	1							
3													
4	7	8	9	10	11	12							
5													
6	18	17	16	15	14	13							
7													
8	19	20	21	22	23	24							
9													
10	30	29	28	27	26	25							
11													
12	31	32	33	34	35	36							
13													

I, Kenneth L. Ross, in a field survey on AUGUST, 1996, do hereby certify that under requirements of P.A. 74, Michigan P.A. of 1970, the corner points mentioned in lines 1 and 2 above were in conformance with regulations and rules therefore as required in the current manual of survey instructions of the United States Department of the Interior, Bureau of Land Management or by a decree of a Court of Law and/or that the corner points mentioned in lines 3, 4 and 5 above were in conformance with the rules of the Michigan Board of Land Surveyors or by a Decree of a Court of Law; established, re-established, monumented, re-monumented, recovered, found as expressed below:

NOTE: Not more than 4 corners, all in the same town and range, may be recorded on this certificate.

A. Description of original monument and accessories and/or subsequent restoration:


In 1839, John Brink, set the original corner, Stating "Set Post common to Sections 14, 15, 22 and 23. Witnesses taken: (1) 9" Beech, N78°W, 31 links, (2) 12" Beech, S18°E, 42 links. In May 1881, C. E. Mitchell, found corner identified by Witness Trees still standing (GLO). In 1977, Norm Ochs, RLS, found Axle shaft and filed an LCRC, Liber 2, page 70, Witnesses Given: (3) P.P. S16°W, 62.64', (4) Guy Pole, S28°E, 93.71'. In May 1979, Kenneth L. Ross, RLS, Found 3/4" Axle Shaft, Witnesses Given: (5) P.P. S16°W, 62.66', (6) Guy Pole, SE, 93.69' Used in survey of Section 14, T.20N., R.16W., and Section 23, T.20N., R.16W.. Mason County Road Commission Records, Identified corner as stake, no witnesses given.

B. Description of corner evidence found and/or method applied in restoring or reestablishing corner:

In August, 1996, I found a 1/2" Re-bar. Fits Distances West and North, Witnesses (3), (5) same, standing and in good condition, Witnesses (4) and (6) same, standing and in good condition. I cross pined the existing 1/2" iron and pulled. Searched the area and found no other evidence to dispute the location of this corner. Witnesses (1) and (2) have been destroyed.

C. Description of monument for corner and accessories established to perpetuate locating the position of the corner:

I replaced the 1/2" iron Re-bar, in the exact location with a Standard Mason County Monument, placed 1.0' below the surface of the gravel, and is accepted as a careful and faithful reestablishment of the position of the original corner. Witnesses taken or checked: (5) Spike in P.P. S16°W, 66.24"
 (6) Spike in Guy Pole, S28°E, 94.08'
 Spike in P.P. N05°W, 270.15'
 Spike in P.P. N03°W, 306.31'

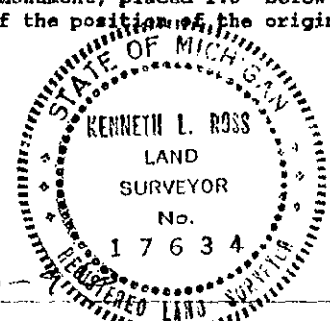

Signed by [Signature]
 Surveyor's Michigan License No. 17634

Date 9-30-96

Peer Group Reviewed and Approved
 Date: 9-30-96
[Signature]
 Kenneth L. Ross
 Mason County Surveyor

FORM APPROVED BY MICHIGAN STATE BOARD OF LAND SURVEYORS, JAN. 28, 1971
 REVISED MAY 14, 1975
 REVISED JAN., 1983
 ADAPTED FOR WORD PROCESSING MARCH, 1993