

**SURVEY & REMONUMENTATION**

MAY 07 1997

COMMISSION

**LAND CORNER RECORDATION CERTIFICATE**


Filing Requirement of Act 74, Mich. P.A. 1970

For corners in  
Mason County  
 (County) Located In: Corner Code #

1. Public Land Survey T 20N. R 16W T-9  
 T R  
 T R  
 T R

2. Property Controlling S T R  
 in Section S T R

3. Miscellaneous S T R  
 Property in Sec. S T R

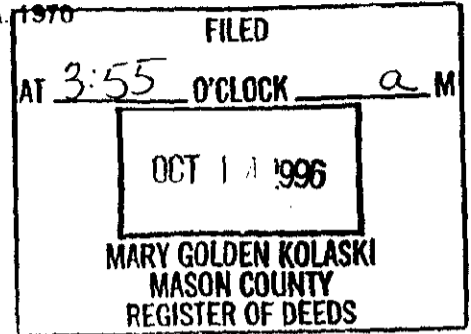

4. Lot No. \_\_\_\_\_, Recorded Plat \_\_\_\_\_  
 5. Private Claims \_\_\_\_\_

I, Kenneth L. Ross, in a field survey on August, 1996, do hereby certify that under requirements of P.A. 74, Michigan P.A. of 1970, the corner points mentioned in lines 1 and 2 above were in conformance with regulations and rules therefore as required in the current manual of survey instructions of the United States Department of the Interior, Bureau of Land Management or by a decree of a Court of Law and/or that the corner points mentioned in lines 3, 4 and 5 above were in conformance with the rules of the Michigan Board of Land Surveyors or by a Decree of a Court of Law; established, re-established, monumented, re-monumented, recovered, found as expressed below:


	A	B	C	D	E	F	G	H	I	J	K	L
1												
2	6	5	4	3	2	1						
3												
4	7	6	5	4	3	2	1					
5												
6	18	17	16	15	14	13						
7												
8	19	20	21	22	23	24						
9												
10	30	29	28	27	26	25						
11												
12	31	32	33	34	35	36						
13												

**NOTE: Not more than 4 corners, all in the same town and range, may be recorded on this certificate.**

A. Description of original monument and accessories and/or subsequent restoration:  
 In 1839, John Brink, laid out the original section, stating "Set Post common to sections, 22, 23, 26 and 27,"  
 Witnesses Given: (1) 22" Beech, N24°E, 16 links, (2) 14" Beech, S26°W, 24 links. In May, 1881, C. E. Mitchell stated "Found corner identified by Witness Trees still standing". No Witnesses Given. In April, 1966, Robert Griffin, RLS, found an iron pipe and replaced with a 5" square X 3' concrete post with a brass cap, set 1.0 foot below the asphalt road surface and filed an LCRC, Liber 1, Page 107, Mason County Records. Witnesses Given: (3) SW Corner Basement wall N41°E, 96.30', (4) Top center Triangle Concrete Post, S64°E, 55.31', (5) 6"X7" Cedar Post, S45°E, 46.7', (6) Brass Tag (RLS # 13584) in NW side of Tel. Pole, S46°W, 41.22', (7) 16 penny spike in side of P.P. N40°W, 43.79'. In August, 1975, Kenneth L. Ross, found a "T" iron at this location, Witnesses (6) and (7) above given and witness taken, (8) 24" Box Elder, S75°W, 91.93'. In 1988 and 1990 Kenneth L. Ross used this corner in a survey. In 1993, Kenneth L. Ross, RLS, found a 16 penny spike over iron. Witnesses (8) given and new witnesses taken: (9) P.P. S73°E, 142.88'.

B. Description of corner evidence found and/or method applied in restoring or reestablishing corner:  
 In August, 1996, I found a 16 penny spike over the 5" square X 3' concrete Monument as described by Griffin above. Witnesses (1), (2), (4), (5), have been destroyed. Witnesses (3), (6), (7), (8), and (9) are standing and in good condition. I found no other evidence to dispute the location of this corner.

C. Description of monument for corner and accessories established to perpetuate locating the position of the corner:  
 I left the 5" square X 3' Concrete Monument, with brass cap in place and accepted as a careful re-establishment of the position of the original corner. Witnesses checked:  
 (3) SW Corner Basement Wall, N41°E, 96.30'  
 (6) Spike and Brass Tag (RLS # 13584), in NW Side of P.P. S46°W, 41.22'  
 (7) 16 penny spike in P.P. N40°W, 43.79'  
 (8) Spike in 24" Box Elder, S75°W, 91.03'  
 (9) Spike in P.P. S73°E, 142.86'

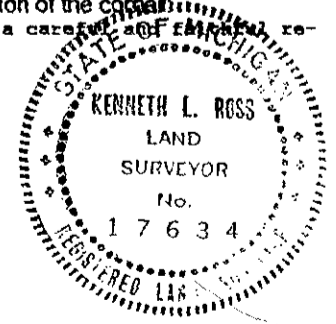

Signed by [Signature] Date 9-30-96  
 Surveyor's Michigan License No. 17634

Peer Group Reviewed and Approved  
 Date: 9-30-96  
[Signature]  
 Mason County Surveyor

FORM APPROVED BY MICHIGAN STATE BOARD OF LAND SURVEYORS, JAN. 28, 1971  
 REVISED MAY 14, 1975  
 REVISED JAN., 1983  
 ADAPTED FOR WORD PROCESSING MARCH, 1993