

FEB 08 2000

LAND CORNER RECORDATION CERTIFICATE

Filing Requirement of Act 74, Mich. P.A. 1970

SECTION

For corners in  
MASON  
 (County)

Located In: \_\_\_\_\_ Corner Code # \_\_\_\_\_

1. Public Land Survey T 20N R 16W \_\_\_\_\_ J-3  
 T \_\_\_\_\_ R \_\_\_\_\_  
 T \_\_\_\_\_ R \_\_\_\_\_  
 T \_\_\_\_\_ R \_\_\_\_\_


2. Property Controlling S \_\_\_\_\_ T \_\_\_\_\_ R \_\_\_\_\_  
 in Section S \_\_\_\_\_ T \_\_\_\_\_ R \_\_\_\_\_

3. Miscellaneous S \_\_\_\_\_ T \_\_\_\_\_ R \_\_\_\_\_

Property in Sec. S \_\_\_\_\_ T \_\_\_\_\_ R \_\_\_\_\_

4. Lot No. \_\_\_\_\_, Recorded Plat \_\_\_\_\_

5. Private Claims \_\_\_\_\_

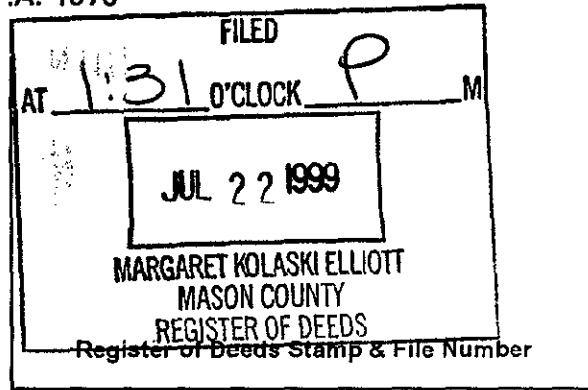

I, Kenneth L. Ross, in a field survey on May 22, 1999, do hereby certify that under requirements of P.A. 74, Michigan P.A. of 1970, the corner points mentioned in lines 1 and 2 above were in conformance with regulations and rules therefore as required in the current manual of survey instructions of the United States Department of the Interior, Bureau of Land Management or by a decree of a Court of Law and/or that the corner points mentioned in lines 3, 4 and 5 above were in conformance with the rules of the Michigan Board of Land Surveyors or by a Decree of a Court of Law; established, re-established, monumented, re-monumented, recovered, found as expressed below:

NOTE: Not more than 4 corners, all in the same town and range, may be recorded on this certificate.

A. Description of original monument and accessories and/or subsequent restoration:  
 1/4 Corner Common to Sections 2 and 11, T.20N., R.16W.,  
 GLO, 3ed quarter, 1839  
 John Brink, "set quarter sec. Post"  
 39.83 chains (2628.78')  
 (1) White Pine, 8", N51°W, 13 links  
 (2) White Pine, 8", S23°E, 15 links  
 May, 1916, Book 2, page 247 & 248  
 C.E. Mitchell, "established 1/4 post"  
 (3) Oak, 11", S60°E, 73 links  
 (4) Pine, 9", N33°E, 54 links  
 Distance West to I-3, 2659.8'  
 Distance East to K-3, 2659.8'  
 July, 1920, C.E. Mitchell (Section)  
 January, 1922, DeYoung (Replat)  
 "Stake for Corner" same drawing  
 (5) White Pine, 12", S15°W, 66'  
 (6) White Oak, 7", N50°E, 33.8'  
 July, 1956, Dwg. K-17, K.B. Stephens  
 "Established 1" iron pipe" No Witnesses  
 Distance West to I-3, 2643.04'  
 Distance East to K-3, 2643.04'

February, 1976, LCRC L. 1, p. 284  
 James T. Nordlund, "established  
 1/4 post on a line between NE & NW  
 Section Cors. Midway between them."  
 Set 4" X 36" Conc. Monument  
 (7) Jack pine, 16", Due North, 35.85'  
 (8) White Oak, 8", Due East, 17.43'  
 (9) Red Pine, 10", Due West, 29.42'  
 Cor lies 40 feet South and 30 feet  
 East of pine plantation and 350 feet  
 North of east-west trail.  
 August, 1980, Act 132, L. 285, p. 246  
 Clinton E. Cole, No comment on corner  
 Distance North to Center 1/4 Cor, 2693.64'  
 May, 1983, LCRC, L.2, p. 105  
 K.L. Ross, "Found 1" Pipe"  
 (10) Black Oak, 20", S25°W, 7.55'  
 (11) White Oak, 14", N79°W, 23.10'  
 (12) Black Oak, 10", N20°E, 39.89'  
 Distance West to I-3, 2642.90'  
 Distance East to K-3, 2642.70'


May, 1988, Act 132  
 K.L. Ross, "fd. 1" pipe"  
 'Distance West to I-3, 2642.96'  
 Distance East to K-3, 2642.64'  
 September, 1988, Patrick R.  
 Leemon, Fd. 1" X 21" pipe"  
 Liber 2, page 299, Replaced  
 with, "6" X 60" Concrete Mon.  
 Witnesses (10) thru (12) given.  
 (13) Pine Post, East, 2.15'  
 Distance West to I-3, 2642.90'  
 Distance East to K-3, 2642.70'

|    | A  | B  | C  | D  | E  | F  | G | H | I | J | K | L | M |
|----|----|----|----|----|----|----|---|---|---|---|---|---|---|
| 1  |    |    |    |    |    |    |   |   |   |   |   |   |   |
| 2  | 6  | 5  | 4  | 3  | 2  | 1  |   |   |   |   |   |   |   |
| 3  |    |    |    |    |    |    |   |   |   |   |   |   |   |
| 4  | 7  | 8  | 9  | 10 | 11 | 12 |   |   |   |   |   |   |   |
| 5  |    |    |    |    |    |    |   |   |   |   |   |   |   |
| 6  | 18 | 17 | 16 | 15 | 14 | 13 |   |   |   |   |   |   |   |
| 7  |    |    |    |    |    |    |   |   |   |   |   |   |   |
| 8  | 19 | 20 | 21 | 22 | 23 | 24 |   |   |   |   |   |   |   |
| 9  |    |    |    |    |    |    |   |   |   |   |   |   |   |
| 10 | 30 | 29 | 28 | 27 | 26 | 25 |   |   |   |   |   |   |   |
| 11 |    |    |    |    |    |    |   |   |   |   |   |   |   |
| 12 | 31 | 32 | 33 | 34 | 35 | 36 |   |   |   |   |   |   |   |
| 13 |    |    |    |    |    |    |   |   |   |   |   |   |   |

B. Description of corner evidence found and/or method applied in restoring or reestablishing corner:  
 1/4 Corner Common to Sections 2 and 11, T.20N., R.16W.,  
 Found a 6" square stamped Concrete Monument as described by Patrick R. Leemon above. Monument projects approximately 1.5' above the ground surface. Witnesses (1) thru (9) have been destroyed. Witnesses (10) thru (13) are standing and in good condition. I found no other evidence to dispute the location of this corner.

C. Description of monument for corner and accessories established to perpetuate locating the position of the corner:  
 1/4 Corner Common to Sections 2 and 11, T.20N., R.16W.,  
 I left the 6" square Concrete Monument in place and accepted as a careful and faithful re-establishment of the position of the original corner.  
 (10) 22" Black Oak, existing 60d spike NW side, S25°W, 7.53'  
 (11) 14" White Oak, existing 60d spike South side, N79°W, 22.10'  
 (12) 12" Black Oak, existing 60d spike SE side, N20°E, 39.89'  
 (13) Pine Post, East, 2.1' (No nail)  
 Distance West to I-3, 2642.96' (Ross)  
 Distance East to K-3, 2642.64' (Ross)

LIBER 4 PAGE 279

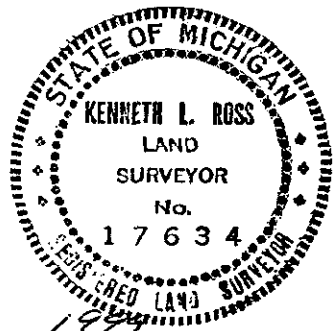

Signed by [Signature] Date July 21, 1999  
 Surveyor's Michigan License No. 17634

Peer Group Reviewed and Approved  
 Done: Shirley A. [Signature] - 1999  
[Signature]  
 Kenneth L. Ross