

SURVEY & REMONUMENTATION

FEB 08 2000

LAND CORNER RECORDATION CERTIFICATE

Filing Requirement of Act 74, Mich. P.A. 1970

SECTION

For corners in MASON Located In: _____ Corner Code # _____
 (County)

1. Public Land Survey T 20N R 16W _____ K-3
 T _____ R _____
 T _____ R _____
 T _____ R _____


2. Property Controlling S _____ T _____ R _____
 in Section S _____ T _____ R _____

3. Miscellaneous S _____ T _____ R _____

Property in Sec. S _____ T _____ R _____

4. Lot No. _____, Recorded Plat _____

5. Private Claims _____

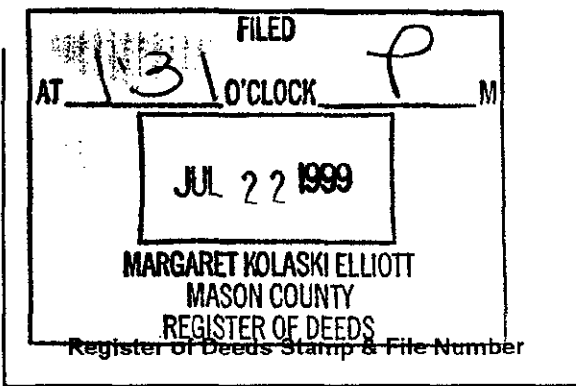

	A	B	C	D	E	F	G	H	I	J	K	L	M
1													
2	6	5	4	3	2	1							
3													
4	7	8	9	10	11	12							
5													
6	18	17	16	15	14	13							
7													
8	19	20	21	22	23	24							
9													
10	30	29	28	27	26	25							
11													
12	31	32	33	34	35	36							
13													

I, Kenneth L. Ross, in a field survey on May 22, 1999, do hereby certify that under requirements of P.A. 74, Michigan P.A. of 1970, the corner points mentioned in lines 1 and 2 above were in conformance with regulations and rules therefore as required in the current manual of survey instructions of the United States Department of the Interior, Bureau of Land Management or by a decree of a Court of Law and/or that the corner points mentioned in lines 3, 4 and 5 above were in conformance with the rules of the Michigan Board of Land Surveyors or by a Decree of a Court of Law; established, re-established, monumented, re-monumented, recovered, found as expressed below:

NOTE: Not more than 4 corners, all in the same town and range, may be recorded on this certificate.

A. Description of original monument and accessories and/or subsequent restoration:
 Corner Common to Sections 1,2,11 and 12, T.20N., R.16W.,
 GLO by John Brink, 1839 July, 1956, Dwg. K-17, K.B. Stephens
 Set Post Common To 1,2,11 & 12 No Witnesses Given,
 (1) P. Pine, 9", N61°W, 64 links(42.24') Distance West to J-3, 2643.04'
 (2) P. Pine, 7", S59°E, 88 links(58.08')

May, 1916, Book 2, pages 247 & 248 Richard H. Kraft, Dwg # K-62
 C.E. Mitchell, "Cor. Set by remains No Witnesses Given
 Of witness stumps" Distance East to L-3, 2656.51 feet
 (3) Oak, 7", S22°E, 83 links(54.78') Distance South to K-4, 2775.00 feet
 (4) Oak, 5", S63°W, 25 links(16.5')
 Distance West to J-3, 2659.8'
 Distance North to K-2, 2640.00'


Robert Griffin, June, 1972, LCRC
 Liber 1, Page 49, Found 6" square Conc Monument
 Replaced with a 6" square X 48" long Conc. Monument
 (7) 4" square X 7' long treated Pine Post, North, 2.2 feet
 (8) Black Oak, 7" S 75° W, 77.74 feet
 (9) Black Oak, 6", N 63° W, 82.25 feet
 (10) White Oak, 7", N 12° W, 91.16 feet

Survey by C.E. Mitchell 1920 (Section)
 1922, DeYoung, (Replat) same dwg.
 States Standard Monument
 (5) Pine, 10", N 70° W, 20.2 feet
 (6) Pine, 10", N 82°E, 5.3 feet

Kenneth L. Ross, Act 132, File 10488S, May 1988 Found Griffin Monument No Witnesses Given.
 Distance West to J-3, 2642.64 feet, Distance South to K-4, 2763.12 feet

B. Description of corner evidence found and/or method applied in restoring or reestablishing corner:
 Corner Common to Sections 1,2,11 and 12, T.20N., R.16W.,
 Found the 6" square Concrete Monument as described above by Robert Griffin, 1.5' above the surface of the ground.
 Witnesses (1) thru (6) have been destroyed. Witnesses (7) (thru (9) are standing and in good condition, Witness (10) Has been cut with only the stump remaining. I found no other evidence to dispute the location of this corner.

C. Description of monument for corner and accessories established to perpetuate locating the position of the corner:
 Corner Common to Sections 1,2,11 and 12, T.20N., R.16W.,
 I left the 6" square Concrete Monument in place as described by Griffin in LCRC, recorded in Liber 1, page 49 and Accepted as a careful and faithful perpetuation of the position of the original corner.
 (7) 4" square treated post, existing nail and brass cap, west side, North, 2.20'
 (8) 10" Black Oak, existing dock spike South side, S75°W, 77.74'
 (9) 8" Black Oak, existing dock spike, NE side, N63°W, 82.25'
 (10) remains of 7" White Oak, stump, existing dock spike, east side, N12°W, 91.16'
 (11) NBT, White Oak, 12", set 60d spike NW side, S60°W, 19.82'

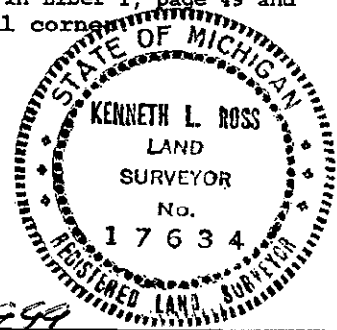

Signed by [Signature] LIBER 4 PAGE 280 Date July 21, 1999
 Surveyor's Michigan License No. 17634
 Peer Group Reviewed and Approved Date: July 14, 1999
 FORM APPROVED BY MICHIGAN STATE BOARD OF LAND SURVEYORS, JAN. 28, 1971
 REVISED MAY 14, 1971
 REVISED JAN., 1982
 ADAPTED FOR WORD PROCESSING MARCH, 1982