

**SURVEY & REMONUMENTATION**

**FEB 08 2000**

**LAND CORNER RECORDATION CERTIFICATE**

Filing Requirement of Act 74, Mich. P.A. 1970

**SECTION**


For corners in MASON Located In: \_\_\_\_\_ Corner Code # \_\_\_\_\_  
 (County)

1. Public Land Survey T 20N R 16W \_\_\_\_\_ K-4  
 T \_\_\_\_\_ R \_\_\_\_\_  
 T \_\_\_\_\_ R \_\_\_\_\_  
 T \_\_\_\_\_ R \_\_\_\_\_

2. Property Controlling S \_\_\_\_\_ T \_\_\_\_\_ R \_\_\_\_\_  
 in Section S \_\_\_\_\_ T \_\_\_\_\_ R \_\_\_\_\_

3. Miscellaneous S \_\_\_\_\_ T \_\_\_\_\_ R \_\_\_\_\_

Property in Sec. S \_\_\_\_\_ T \_\_\_\_\_ R \_\_\_\_\_

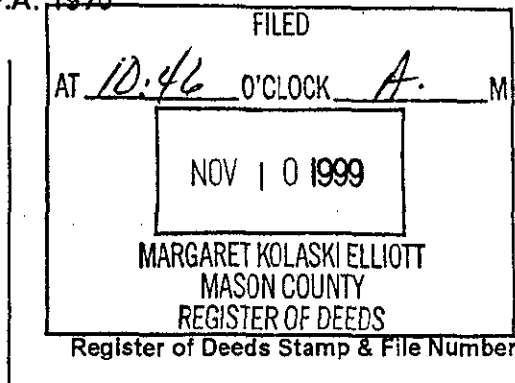

4. Lot No. \_\_\_\_\_, Recorded Plat \_\_\_\_\_  
 5. Private Claims \_\_\_\_\_

	A	B	C	D	E	F	G	H	I	J	K	L	M
2	6	5	4	3	2	1							
4	7	8	9	10	11	12							
6	18	17	16	15	14	13							
8	19	20	21	22	23	24							
10	30	29	28	27	26	25							
12	31	32	33	34	35	36							

I, Kenneth L. Ross, in a field survey on October 9, 1999, do hereby certify that under requirements of P.A. 74, Michigan P.A. of 1970, the corner points mentioned in lines 1 and 2 above were in conformance with regulations and rules therefore as required in the current manual of survey instructions of the United States Department of the Interior, Bureau of Land Management or by a decree of a Court of Law and/or that the corner points mentioned in lines 3, 4 and 5 above were in conformance with the rules of the Michigan Board of Land Surveyors or by a Decree of a Court of Law; established, re-established, monumented, re-monumented, recovered, found as expressed below:

NOTE: Not more than 4 corners, all in the same town and range, may be recorded on this certificate.

A. Description of original monument and accessories and/or subsequent restoration:  
 K-4, 1/4 Corner Common to Sections 11 and 12, T.20N., R16W.,

- |   |  |   |
|---|--|---|
| <p>GLO by John Brink, 1839<br/>                 "set quarter section post"<br/>                 (1) White Oak, 8", N70 1/2°E, 8 links, (4.8')<br/>                 (2) White Oak, 6", N35°W, 8 links (4.8')</p> <p>C.E. Mitchell, 1917, Book 2, page 520<br/>                 "Established by measurement" does not state what he set.<br/>                 (3) White Oak, 7", N17°E, 14.3 links (9.44')<br/>                 (4) White Oak, 10", N56 1/2°W, 14.8 links (9.77')</p> <p>C.E. Mitchell, 1920, Section Survey)<br/>                 DeYoung, 1922, Replat (Same Drawing)<br/>                 "Standard Cement Corner"<br/>                 (5) Oak, 13", S30°W, 51.4'<br/>                 (6) Black Oak, 10", N17°W, 94.5'</p> | <p>K.B. Stephens, 1956, dwg. K-17<br/>                 "existing concrete monument"<br/>                 no witnesses given,<br/>                 no distances given.</p> <p>Richard H. Kraft, 1971, Act 132<br/>                 No comment on corner.<br/>                 Distance North to K-3, 2775.00'<br/>                 Distance South to K-5, 2762.53'</p> <p>K.L. Ross, 1978, Act 132,<br/>                 LCRC, Liber 2, page 30<br/>                 "Ed. Sq. Monument by Mitchell"<br/>                 (7) 12" Black Oak, S75°W, 24.15'<br/>                 (8) 12", White Oak, N55°W, 38.23'<br/>                 (9) 12" Black Oak, N10°E, 31.42'<br/>                 (10) 14" Black Oak, N65°E, 28.00'</p> | <p>K.L. Ross, 1988, Act 132<br/>                 "Existing Monument by Towns possibly meant Mitchell)<br/>                 No new witnesses given<br/>                 Distance North to K-3, 2763.12'<br/>                 Distance South to K-5, 2761.24'</p> |
|---|--|---|


B. Description of corner evidence found and/or method applied in restoring or reestablishing corner:  
 K-4, 1/4 Corner Common to Sections 11 and 12, T.20N., R16W.,

I found a 4" square concrete Monument with a 1" pipe in the center as described by K. Ross above. Witnesses (1) thru (6) have been destroyed. Witnesses (7) thru (10) are standing and in good condition. I found no other evidence to dispute the location of this corner.

C. Description of monument for corner and accessories established to perpetuate locating the position of the corner:  
 K-4, 1/4 Corner Common to Sections 11 and 12, T.20N., R16W.,

I left the existing 4" square Concrete Monument with 1" Pipe in the center, in place and accepted this corner as the best available evidence of the re-establishment of the Original Corner.

- (7) Existing 60d spike NW side 15", Black Oak, S75°W, 24.15'
- (8) Existing 60d spike SE side 16", White Oak, N55°W, 38.23'
- (9) Existing 60d spike West side 16" Black Oak, N10°E, 31.42'
- (10) Existing 60d spike SE side 18" Black Oak, N65°E, 28.00'
- (11) Old Cedar Post South 1.0'
- (12) Set 60d spike South side 8" Black Oak, N 89°E, 52.22'

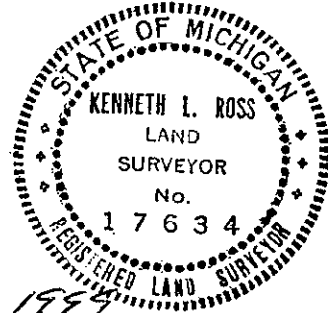

Signed by [Signature] Date Nov. 4, 1999  
 Surveyor's Michigan License No. 17634

Peer Group Reviewed and Approved  
 Date: 11-8-99  
[Signature]  
 Kenneth L. Ross  
 Mason County Surveyor