

**FEB 08 2000**

**LAND CORNER RECORDATION CERTIFICATE**  
 Filing Requirement of Act 74, Mich. P.A. 1970

**SECTION**

For corners in MASON Located in: \_\_\_\_\_ Corner Code # \_\_\_\_\_  
 (County)

1. Public Land Survey T 20N R 16W \_\_\_\_\_ K-6  
 T \_\_\_\_\_ R \_\_\_\_\_  
 T \_\_\_\_\_ R \_\_\_\_\_  
 T \_\_\_\_\_ R \_\_\_\_\_


2. Property Controlling S \_\_\_\_\_ T \_\_\_\_\_ R \_\_\_\_\_  
 in Section S \_\_\_\_\_ T \_\_\_\_\_ R \_\_\_\_\_

3. Miscellaneous S \_\_\_\_\_ T \_\_\_\_\_ R \_\_\_\_\_

Property in Sec. S \_\_\_\_\_ T \_\_\_\_\_ R \_\_\_\_\_

4. Lot No. \_\_\_\_\_, Recorded Plat \_\_\_\_\_

5. Private Claims \_\_\_\_\_

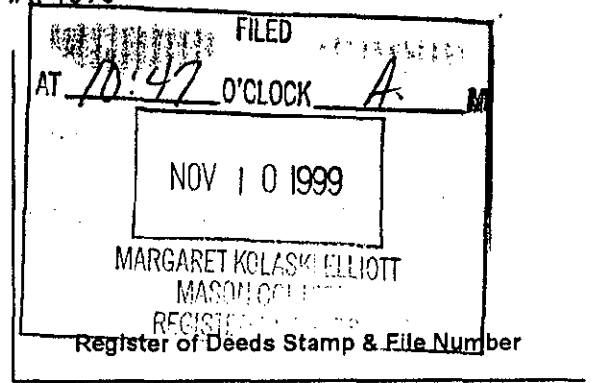

	A	B	C	D	E	F	G	H	I	J	K	L	M
1													
2	6	5	4	3	2	1							
3													
4	7	8	9	10	11	12							
5													
6	18	17	16	15	14	13							
7													
8	19	20	21	22	23	24							
9													
10	30	29	28	27	26	25							
11													
12	31	32	33	34	35	36							
13													

I, Kenneth L. Ross, in a field survey on October 9, 1999, do hereby certify that under requirements of P.A. 74, Michigan P.A. of 1970, the corner points mentioned in lines 1 and 2 above were in conformance with regulations and rules therefore as required in the current manual of survey instructions of the United States Department of the Interior, Bureau of Land Management or by a decree of a Court of Law and/or that the corner points mentioned in lines 3, 4 and 5 above were in conformance with the rules of the Michigan Board of Land Surveyors or by a Decree of a Court of Law; established, re-established, monumented, re-monumented, recovered, found as expressed below:

**NOTE:** Not more than 4 corners, all in the same town and range, may be recorded on this certificate.

**A. Description of original monument and accessories and/or subsequent restoration:**  
 K-6, ¼ Corner Common to Sections 13 and 14, T.20N., R.16W.,

- GLO by John Brink, 1839  
Set quarter section post
- (1) White Pine, N 55°E, 24 links, (15.84')
- (2) White Pine, S 45°E, 30 links, (19.80')
- C.E. Mitchell, Undated, Book 2, page 200  
"Located Quarter Corner by Government Wit."
- (3) White Oak, 11", N23°E, 22'
- (4) White Oak, 5", S12°E, 32'
- Distance North to K-5, 2682.24'
- R.O. Towns, 1908, Book 2, page 208  
"Located by stake and stump of Gov't. Wit.  
No new witnesses given  
Distance North to K-5, 2686.20'  
Distance South to K-7, 2331.12'
- Patrick A. Salisbury, 1974. LCRC  
Liber, 1, page 234, "Found  
6" X 6" X 36" Conc. Monument.
- (5) 8" Black Oak, N60°E, 42.40'
- (6) 8" Black Oak, N38°W, 61.75'
- (7) 16" White Oak, S48°E, 52.97'
- (8) Cor of Field, N38°W, 31'
- Distance North to K-5, 2705.89'  
Distance South to K-7, 2349.34'
- R.A. Griffin, LCRC, Liber 2, page 1, 1974  
Found 6" X 6" X 36" Conc. Monument  
Witnesses (5), (6) and (7) Given.
- Norman L. Ochs, 1979, Act 132, and  
LCRC, Liber 2, page 69, Fd. 5" sq.  
Conc. Monument, witnesses (5), (6)  
And (7) given.  
Distance South to K-7, 2349.34'

K.L. Ross, 1984, Act 132  
"Fd. USFS Monument"  
No Witnesses Given.  
Distance North to K-5, 2707.03'  
Distance South to K-7, 2348.20'

**B. Description of corner evidence found and/or method applied in restoring or reestablishing corner:**  
 K-6, ¼ Corner Common to Sections 13 and 14, T.20N., R.16W.,

I found the 6" X 6" USFS Monument as described by Patrick A. Salisbury above. Witnesses (1) through (4) have been destroyed. Witnesses (5) through (8) are standing and in good condition. I found no other evidence to dispute the location of this corner.

**C. Description of monument for corner and accessories established to perpetuate locating the position of the corner:**  
 K-6, ¼ Corner Common to Sections 13 and 14, T.20N., R.16W.,

I left the existing 6" square USFS Concrete Monument with 3" brass disk in place and accepted this corner as the best available evidence of the re-establishment of the Original Corner.

- (5) Existing 60d spike SW side of 12" Black Oak, N60°E, 42.40'
- (6) Existing 60d spike NE side of 12" Black Oak, N38°W, 61.75'
- (7) Existing 60d spike NE side of 20" White Oak, S48°E, 52.97'
- (8) Cor of Field, N38°W, 31'
- (9) Set 60d spike East side of 12" White Oak S02°W, 82.16'



Signed by [Signature] Date Nov. 4, 1999

Surveyor's Michigan License No. 17634

Peer Group Reviewed and Approved  
 Date: 11-24-99  
[Signature]  
 Kenneth L. Ross  
 Mason County Surveyor