

FEB 08 2000

SECTION

LAND CORNER RECORDATION CERTIFICATE

Filing Requirement of Act 74, Mich. P.A. 1970

For corners in MASON (County) Located In: _____ Corner Code # _____

1. Public Land Survey T 20N R 16W _____ K-7
 T _____ R _____
 T _____ R _____
 T _____ R _____


2. Property Controlling S _____ T _____ R _____
 in Section S _____ T _____ R _____

3. Miscellaneous S _____ T _____ R _____

Property in Sec. S _____ T _____ R _____

4. Lot No. _____, Recorded Plat _____

5. Private Claims _____

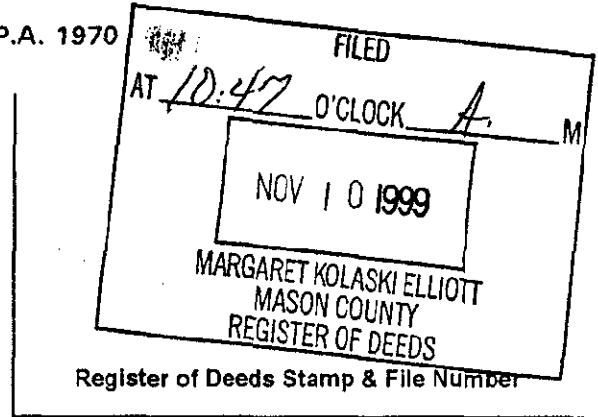

	A	B	C	D	E	F	G	H	I	J	K	L	M
1													
2	6	5	4	3	2	1							
3													
4	7	8	9	10	11	12							
5													
6	18	17	16	15	14	13							
7													
8	19	20	21	22	23	24							
9													
10	30	29	28	27	26	25							
11													
12	31	32	33	34	35	36							
13													

I, Kenneth L. Ross, in a field survey on October 9, 1999, do hereby certify that under requirements of P.A. 74, Michigan P.A. of 1970, the corner points mentioned in lines 1 and 2 above were in conformance with regulations and rules therefore as required in the current manual of survey instructions of the United States Department of the Interior, Bureau of Land Management or by a decree of a Court of Law and/or that the corner points mentioned in lines 3, 4 and 5 above were in conformance with the rules of the Michigan Board of Land Surveyors or by a Decree of a Court of Law; established, re-established, monumented, re-monumented, recovered, found as expressed below:

NOTE: Not more than 4 corners, all in the same town and range, may be recorded on this certificate.

A. Description of original monument and accessories and/or subsequent restoration:
 K-7, Corner Common to Sections 13, 14, 23 and 24, T.20N., R.16W.,

GLO by John Brink, 1839
 Set post sections 13, 14, 23 & 24
 (1) Hemlock, 12", S34°W, 20 links, (13.20')
 (2) Cedar, 11", S77°W, 25 links (16.50')
 (3) South edge of cedar swamp, South 3 chains (198')
 (4) Stream, 100 links wide, North 2.5 chains (165')

R.A. Griffin, 1966, LCRC, Liber, 1, page 113
 "Set 5" square X 48" Conc Monument by deposition of Harry Hasenbank.
 (5) 10" dock spike in NW side 6" cedar, N50°E, 39.83'
 (6) 10" dock spike in SW side, Maple, 8", S54°E, 145.22'
 (7) 6" X 7' Cedar Post, South, 1.4'
 (8) SE Cor Cabin, N31°W, no distance
 (9) 10" dock spike, Ash, N4°W, 9.08'

R.O. Towns, 1908, Book 2, page 208 & 209
 "located stake by government witnesses trees now down" No new witnesses given.
 Distance North to K-6, 2331.12'
 Distance West to J-7, 2727.12'

Patrick Salisbury, 1974, Act 132, Liber 1, page 259
 No Comment on Corner, No Witnesses given.
 Distance North to K-6, 2349.34'
 Distance East to L-7, 2673.20'

Norman L. Ochs, 1979, LCRC Liber 2, page 68
 "Found 5" X 5" X 60" Conc. Monument"
 Witnesses (5), (6), (7) and (9) given.

K.L. Ross Act 132's, 1984, 1988, and 1994 tied this corner, no Witnesses given.
 Distance West to J-7, 2724.05'
 Distance North to K-6, 2348.20'


B. Description of corner evidence found and/or method applied in restoring or reestablishing corner:
 K-7, Corner Common to Sections 13, 14, 23 and 24, T.20N., R.16W.,

I found the 5" X 5" square Concrete Monument (USFS) as described by R.A. Griffin above as monumented and in good condition. Witnesses (1) and (2) have been destroyed. Witnesses (3) and (4) are existing and in good condition. Witnesses (5) through (9) are standing and in good condition. I found no other evidence to dispute the location of this corner.

C. Description of monument for corner and accessories established to perpetuate locating the position of the corner:
 K-7, Corner Common to Sections 13, 14, 23 and 24, T.20N., R.16W.,

I left the existing 5" square USFS Concrete Monument with 3" Brass Cap in place and accepted this corner as the best available evidence of the re-establishment of the Original Corner.

- (5) Existing 10" dock spike in NW side 12" cedar, N50°E, 39.83'
- (6) Existing 10" dock spike in SW side, Maple, 16", S54°E, 145.22'
- (7) Existing nail and brass washer, East side of Treated, 6" X 7' Cedar Post, South, 1.4'
- (9) 10" dock spike, East side 10" Ash, N4°W, 9.08'

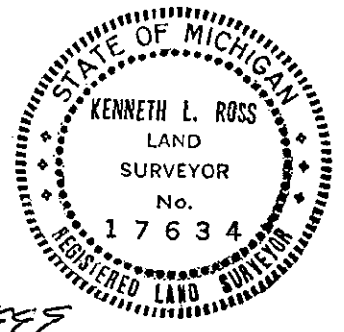

Signed by [Signature]
 Surveyor's Michigan License No. 17634

Date Nov 4, 1999

Peer Group Reviewed and Approved
 Date: 11-04-99
[Signature]
 Kenneth L. Ross
 Mason County Surveyor