

# SURVEY & REMONUMENTATION

MAR 16 1998

## LAND CORNER RECORDATION CERTIFICATE

Filing Requirement of Act 74, Mich. P.A. 1970

### SECTION


For corners in

MASON  
(County)

Located In:

Corner Code #

- |                                    |   |     |   |     |      |
|------------------------------------|---|-----|---|-----|------|
| 1. Public Land Survey              | T | 20N | R | 16W | K-13 |
|                                    | T |     | R |     |      |
|                                    | T |     | R |     |      |
|                                    | T |     | R |     |      |
| 2. Property Controlling in Section | S | T   | R |     |      |
|                                    | S | T   | R |     |      |
| 3. Miscellaneous Property in Sec.  | S | T   | R |     |      |
|                                    | S | T   | R |     |      |

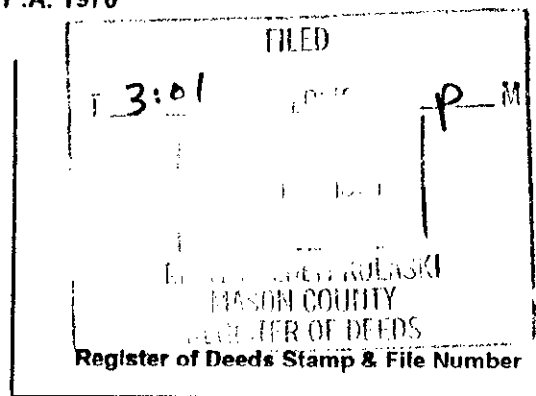

4. Lot No. \_\_\_\_\_, Recorded Plat \_\_\_\_\_  
 5. Private Claims \_\_\_\_\_

I, Kenneth L. Ross, in a field survey on October 27, 19 97, do hereby certify that under requirements of P.A. 74, Michigan P.A. of 1970, the corner points mentioned in lines 1 and 2 above were in conformance with regulations and rules therefore as required in the current manual of survey instructions of the United States Department of the Interior, Bureau of Land Management or by a decree of a Court of Law and/or that the corner points mentioned in lines 3, 4 and 5 above were in conformance with the rules of the Michigan Board of Land Surveyors or by a Decree of a Court of Law, established, re-established, monumented, re-monumented, recovered, found as expressed below:

**NOTE: Not more than 4 corners, all in the same town and range, may be recorded on this certificate.**

A. Description of original monument and accessories and/or subsequent restoration:  
 K-13 Section Corner for Sections 35 and 36, T20N-R16W

1837, Mullett & Brookfield, G.L.O.  
 Set Wood Post  
 #1 Beech 8" N 75° E 23 lks. (15.18 ft.)  
 #2 Beech 10" N 60° W 23 lks. (15.18 ft.)

1962, Robert A. Griffin, RLS# 13584  
 Found a 1" x 48" Iron Pipe

1965, Gregory A. Shadko, RLS# 1934, MDOC  
 Found 1" x 48" Iron Pipe  
 used in survey of Public Access, Gun Lake

1966, Robert A. Griffin, RLS# 13584  
 Replaced in exact location the 1" x 48" Iron with a 5" sq. by 60" long, Conc. Monument with 3" brass disk, Stamped to identify the corner.

- #3 Maple Clump 8" N 14° W 103.96 ft.
- #4 Power pole N 20° E 64.00' (16p nail w/ brass shiner)
- #5 Maple 1" N 87° W 5.90 ft.
- #6 Stone w/ "X" 14" w. x 20" l. S 19° E 79.01 ft.
- #7 Center Brass Disk in conc. mon. closing corner for Sec. 1 and 2, T19N-R16W. East 5.28 ft.
- #8 Cedar Post 5" x 7 ft. North 1.5 ft.

	A	B	C	D	E	F	G	H	I	J	K	L	M
1													
2	6	5	4	3	2	1							
3													
4	7	8	9	10	11	12							
5													
6	18	17	16	15	14	13							
7													
8	19	20	21	22	23	24							
9													
10	30	29	28	27	26	25							
11													
12	31	32	33	34	35	36							
13													

B. Description of corner evidence found and/or method applied in restoring or reestablishing corner:

K-13 Section Corner for Sections 35 and 36, T20N-R16W

On October 27, 1997, I Ken Ross and Kevin Pritchard (survey tech.) found a 6" round concrete monument, by Griffin. Monument has a 3" Brass Cap, stamped to identify the corner. After a through search I found no evidence to disputed the location of this corner.  
 Condition of recorded witnesses are: #1 Gone #2 Gone #3 Found in good condition (no nail) #4 Found in good condition #5 Gone #6 Found in good condition #7 Found in good condition #8 Gone


C. Description of monument for corner and accessories established to perpetuate locating the position of the corner:

K-13 Section Corner for Sections 35 and 36, T20N-R16W

I accepted 6" round concrete monument with brass cap as a substantial marker for this corner, and is accepted as a careful and faithful re-establishment of the position of the original corner.

- Ext"BT" #4 Power pole N 20° E 64.00 ft. (Ext.16p nail w/ shiner)
- Ext"BT" #6 Stone w/ "X" 14" x 20" S 19° E 79.01 ft.
- Maple clump 6" S 03° E 42.03 ft. (Set 60d spike in East side of tree)
- Black Oak 10" S 65° W 43.04 ft. (Set 60d spike in SE side of tree)
- Closing Corner for Section 1 and 2, T19N-R16W East 5.28 feet

Signed by [Signature] Date Nov 5, 1997  
 Surveyor's Michigan License No. 17634

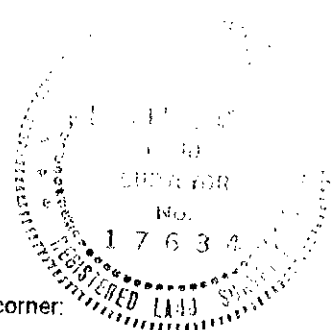

FORM APPROVED BY MICHIGAN STATE BOARD OF LAND SURVEYORS, JAN. 28, 1971  
 REVISED MAY 14, 1975  
 REVISED JAN. 1983  
 ADAPTED FOR WORD PROCESSING MARCH, 1993

LIBER PAGE 140