

SURVEY & REMONUMENTATION

MAR 16 1998

LAND CORNER RECORDATION CERTIFICATE
 Filing Requirement of Act 74, Mich. P.A. 1970


SECTION

For corners in
Mason
 (County)

Located In:

Corner Code #

- 1. Public Land Survey T 20N R 16W _____ H-13 _____
 T _____ R _____
 T _____ R _____
 T _____ R _____
- 2. Property Controlling S _____ T _____ R _____
 in Section S _____ T _____ R _____
- 3. Miscellaneous S _____ T _____ R _____
 Property in Sec. S _____ T _____ R _____

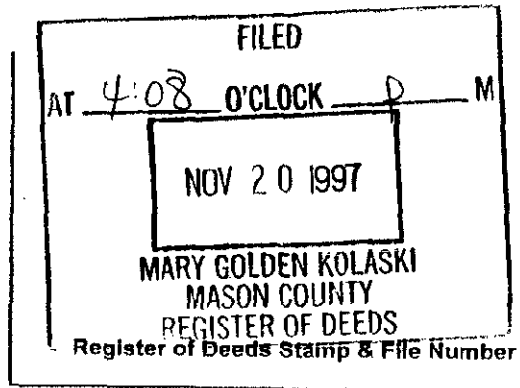

- 4. Lot No. _____ Recorded Plat _____
- 5. Private Claims _____

I, Richard L. Hays, in a field survey on April 1997, do hereby certify that under requirements of P.A. 74, Michigan P.A. of 1970, the corner points mentioned in lines 1 and 2 above were in conformance with regulations and rules therefore as required in the current manual of survey instructions of the United States Department of the Interior, Bureau of Land Management or by a decree of a Court of Law and/or that the corner points mentioned in lines 3, 4 and 5 above were in conformance with the rules of the Michigan Board of Land Surveyors or by a Decree of a Court of Law; established, re-established, monumented, re-monumented, recovered, found as expressed below:

	A	B	C	D	E	F	G	H	I	J	K	L	M
1													
2	6	5	4	3	2	1							
3													
4	7	8	9	10	11	12							
5													
6	18	17	16	15	14	13							
7													
8	19	20	21	22	23	24							
9													
10	30	29	28	27	26	25							
11													
12	31	32	33	34	35	36							
13													

NOTE: Not more than 4 corners, all in the same town and range, may be recorded on this certificate.

A. Description of original monument and accessories and/or subsequent restoration:


H-13 SOUTH QUARTER CORNER OF SECTION 34, T20N-R16W
 1838: G.L.O Post
 10" Hemlock N-48°-E 55 lks (1)
 8" Hemlock N-45°-W 37 lks (2)
 1988: Ross Survey #17634
 Section Survey
 SW Corner West 2643.61' (3)
 SE Corner East 2635.48' (4)

B. Description of corner evidence found and/or method applied in restoring or reestablishing corner:

H-13 SOUTH QUARTER CORNER OF SECTION 34, T20N-R16W
 April 1997: Found a 1/2" Re-Rod.
 Condition of the Witnesses are as follows:
 10" Hemlock N-48°-E 55 lks (1) (GONE)
 8" Hemlock N-45°-W 37 lks (2) (GONE)
 SW Corner West 2643.61' (3) (FOUND)
 SE Corner East 2635.48' (4) (FOUND)

C. Description of monument for corner and accessories established to perpetuate locating the position of the corner:

H-13 SOUTH QUARTER CORNER OF SECTION 34, T20N-R16W
 April 1997: Replace the 1/2" Re-Rod in the exact location with a Standard Mason County Monument and is accepted as the best available evidence of the position of the Original Corner.
 Spike in Northeast Side 4" Black Oak N-20°-W 37.46'
 Spike in West Side 10" White Pine N-44°-W 38.86'
 Spike in Southwest Side 11" White Pine S-52°-E 49.05'
 Closing Corner East 6.45'
 Southwest Corner West 2643.53' (3)
 Southeast Corner East 2635.41' (4)
 Fence Gate Post S-25°-W 32.55'

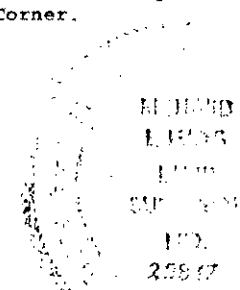

Signed by Richard Hays Date 11/6/97

Surveyor's Michigan License No 25847

FORM APPROVED BY MICHIGAN STATE BOARD OF LAND SURVEYORS, JAN. 28, 1971
 REVISED MAY 14, 1978
 REVISED JAN., 1983
 ADAPTED FOR WORD PROCESSING MARCH, 1993

Peer Group Reviewed
 and Approved
 Date: 11/24/97
[Signature]
 Mason County Surveyor