

SURVEY & REMONUMENTATION


MAY 07 1997

COMMISSION

LAND CORNER RECORDATION CERTIFICATE
Filing Requirement of Act 74, Mich. P.A. 1970

For corners in

Mason (County)	Located In:	Corner Code #
1. Public Land Survey	T 20N R 17W	I-08
	T R	
	T R	
	T R	
2. Property Controlling in Section	S T R	
	S T R	
3. Miscellaneous Property in Sec.	S T R	
	S T R	

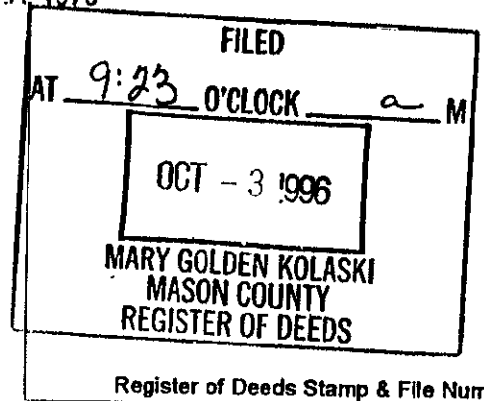

4. Lot No. _____, Recorded Plat _____
5. Private Claims _____

I, Sammy S. Barnett, in a field survey on Sept, 1996 do hereby state that under requirements of P.A. 74, Michigan P.A. of 1970, the corner points mentioned in lines 1 and 2 above were in conformance with regulations and rules therefore as required in the current manual of survey instructions of the United States Department of the Interior, Bureau of Land Management or by a decree of a Court of Law and /or that the corner points mentioned in lines 3, 4 and 5 above were in conformance with the rules of the Michigan Board of Land Surveyors or by a Decree of a Court of Law; established, re-established, monumented, recovered, found as expressed below:

NOTE: Not more than 2 corners, all in the same town and range, may be recorded on this certificate.

	A	B	C	D	E	F	G	H	I	J	K	L
1												
2	6		5		4		3		2		1	
3												
4	7		8		9		10		11		12	
5												
6	10		17		16		15		14		13	
7												
8	19		20		21		22		23		24	
9												
10	30		29		28		27		26		25	
11												
12	31		32		33		34		35		36	
13												

A. Description of original monument and accessories and/or subsequent restoration:

I-08 Corner common to sections 22 & 23, T20N, R17W, (Grant)
1839 John Brink G.L.O.
Set post #4 W. Birch 24" N30E 18.00' 1977 R. Wetherell
#1 B Ash 11" N79E 30 lks. (19.80') 1974 H. Fluharty No monument given
#2 Cedar 11" N38W 18 lks. (11.88') Set 3/8 x 1 1/2" pipe & cap at corner No witnesses given
1966 K.B. Stephens Co. Surveyor of fences & at distance corresponding to record distance from S.W. corner
Set 1" pipe at fence intersection on #5 Maple 10" S03W 9.96'
S.W. side base of 12" box elder #6 Twin Y. Birch N85W 8.60'
#3 W. Birch 6" S25E 29.35' #7 Hemlock 10" N23E 22.45'

B. Description of corner evidence found and/or method applied in restoring or reestablishing corner:


I-08 Corner common to sections 22 & 23, T20N, R17W, (Grant)
On Sept 9, I found 3/8" capped pipe (# 11368). I found no evidence to dispute this location. The condition or the redorded witnesses are:
1 Gone
2 Gone
3 Gone
4 Gone
5 Maple 12" S03W 9.88' spike in W side
6 Found dead
7 Found stump

C. Description of monument for corner and accessories established to perpetuate locating the position of the corner:

I-08 Corner common to sections 22 & 23 T20N, R17W, (Grant)
I replaced the 3/8" pipe, in the exact location, with a Standard Mason County Monument and accepted this location as a careful and faithful reestablishment of the original corner.
5 Maple 12" S03W 9.88' spike in W side
8 Wild Cherry 10" N11W 42.70' spike in E side
9 Cedar 8" S88W 17.68' spike in S. side
10 Red Oak 14" N55W 44.50' spike in NE side
Corner is on the W. side of new gas pipe line with fence to the E.

Signed by Sammy S. Barnett
Surveyor's Michigan License No. 16923

Date 9-27-96

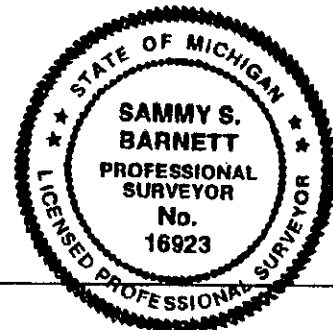

Peer Group Reviewed and Approved
Date: 9-30-96
Keneth L. Ross
Mason County Surveyor